


Section 26 Township 14 Range 14-W

Well No. #2 Krug "A"

Company Saco Oil

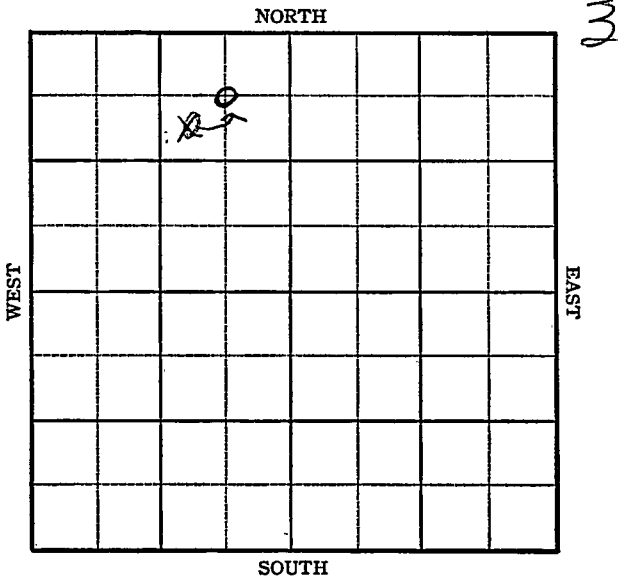

Sec. 26 Twp. 14N R. 14W

Well No. #2 Krug "A" Farm

Saco Oil Company


Hall-Gurney

990-660 Ft. from N. Line

_____ Ft. from S. Line

660
990 Ft. from E. Line

_____ Ft. from W. Line

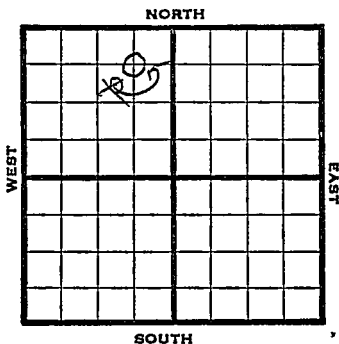

~~SW NE NW~~ C NE NW

1945 Elev. 1805' REPORT

12/28	Location
1946	
1/10	10" - 494' Anhy 810' Drlg. 1475'
1/14	Topeka 2660' Dodge 2853' Lans 2950' T.D. 2953' Run 5".
1/24	5" - 2953' RUST.
1/31	Drlg. 2984' SSO.
2/7	T.D. 3050' 100' oil in 16 hours.
2/14	" " " "
2/21	" " " "
2/28	" " " "
3/7	" " " "
3/14	" " " "
3/21	" " " "
3/28	" " " "
4/4	No test
4/10	" "
4/16	" "
4/23	" "
5/1	Lans 2950 7" @ 2953 TD 3050 Pump 5 Pot. Grav. 36.0.

COMPLETED

KANSAS KansaPool Name Hall-GurneyMap No. K-72 Sec. 26 Twp. 14 R. 14WWell No. 2 Krug "A"Saco Oil CompanyFIRST REPORT Contractor

SW NE NW

SECTION PLAT

990 Ft. from N. Line Ft. from S. Line990 Ft. from E. Line Ft. from W. Line

	o		

Rus el. County

Location XRig up Drilling and Remarks:

RECORD

Cased in., ft.Sand Gas Oil Total Depth

PRODUCTION

1st 24 hrs. Nat. 1st 24 hrs. after shot Gas Cu. Ft.Dry Hole Abandoned

Date

DEC 28 1945 19S. J. LEWIS Scout

KANSAS

Kansas

Pool Name Hall-Gurney

Map No. 72 Sec. 26 Twp. 14 R. 14W

Well No. 2 Krug "A"

Saco Oil

Company

CORRECTION

Contractor

C NE NW

SECTION PLAT

660 Ft. from N. Line

_____ Ft. from S. Line

660 Ft. from E. Line

_____ Ft. from W. Line

	♂		

Russell County

Location _____

Rig up _____

Drilling and Remarks:
reported
SW NE NW

RECORD

Cased _____ in., _____ ft.

Sand _____

Gas _____

Oil _____

Total Depth _____

PRODUCTION

1st 24 hrs. Nat. _____

1st 24 hrs. after shot _____

Gas _____ Cu. Ft.

Dry Hole _____

Abandoned _____

Date

JAN 9 1946 19

S. J. LEWIS Scout

KANSAS Kansas Pool Name Hall-Gurney

Map No. 72 Sec. 26 Twp. 14 R. 14W

Well No. 2 Krug "A"

Saco Oil Company

COMPLETED

Contractor

E 11805

C NE NW

SECTION PLAT

660 Ft. from N. Line

 Ft. from S. Line

660 Ft. from E. Line

 Ft. from W. Line

	0		

Russell County

Location

Rig up

Drilling and Remarks:

Lions 2950

3" C 2953

Pump 500

36 1/2 Gr

RECORD

Cased in., ft.

Sand

Gas

Oil

Total Depth 3050

PRODUCTION

1st 24 hrs. Nat.

1st 24 hrs. after shot

Gas Cu. Ft.

Dry Hole

Abandoned

Date

MAY 1 1946 19

S. J. LEWIS Scout