
FORM 51 25M 8-50 WESTERN Russell KANSAS

Section 26 Township 14 Range 14 W

Well No. # 3 Krug "A"

Company Saco Oil

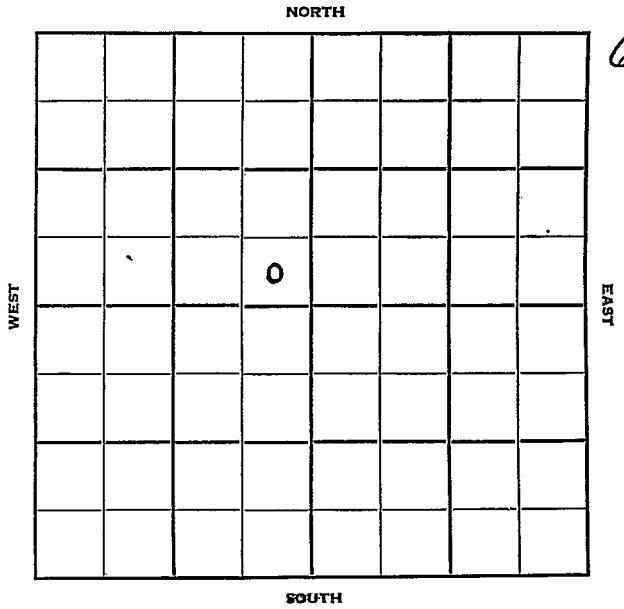

FORM 252-B
10M 10-50 PETROL

Russell

KANSAS

Sec. 26 Twp. 14 R. 14W

Well No. #3 Krug "A" Farm

Saco Oil Company

Murfin Drlg. Contractor

Hall-Gurney Pool


____ Ft. from N. Line

330 Ft. from S. Line

330 Ft. from E. Line

____ Ft. from W. Line

SE SE NW

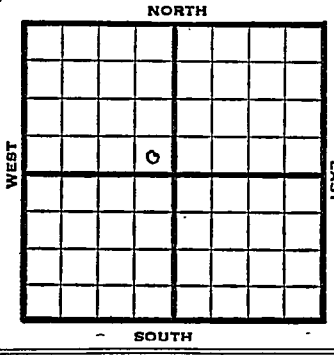

1952	Elev.1782' REPORT
3/19	Location
3/25	MI
4/1	15" @ 37' Drlg. 220'
4/9	12" @ 247 10" @ 437 Anhy 758 8" @ 765 Drlg. 860'
4/23	Tarkio 2306' 7" @ 2306½' TD 2323'
4/30	D.P.
5/7	NR
5/14	Spud 3-21-52 Oil Well TD 2323 15" @ 37 12" @ 247 10" @ 437 Anhy 758 8" @ 765 Tarkio 2306 7" @ 2306 TD 2323 CO to 2312 Hydro Comp. 25 bopd COMPLETED

FORM 275 FOR SALE BY KANSAS BLUE PRINT CO.


County Russell State Kansas

Sec. 26 (Blk. Twp.) 14 (Sur. Rge.) 14W Map No.

Operator Saco Oil

Well No. 3 Farm Krug "A"

Elev. Location SE SE NW

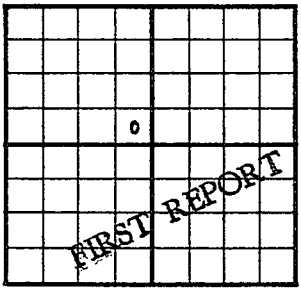

330 Ft. From S Line NW

330 Ft. From E Line Quarter

1st. Report MAR 19 1952

Completion

Remarks Murfin Drlg. - Contr.

Spudding Date

Drlg. Data Hall-Gurney Pool

Location

J. G. McGEHEE

FORM 275 FOR SALE BY KANSAS BLUE PRINT CO.


County Russell State Kansas

Sec. 26 (Blk. Twp.) 14 (Sur. Rge.) 14W Map No.

Operator Saco Oil

Well No. 3 Farm Krug "A"

Elev. 1782 Location SE SE NW

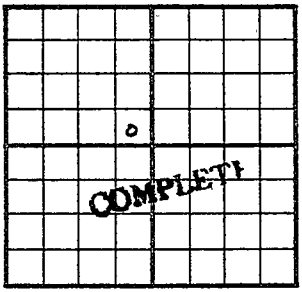

330 Ft. From S Line NW

330 Ft. From E Line Quarter

1st. Report

Completion MAY 14 1952

Remarks Hall-Gurney Pool
Murfin Drlg. - Contr.

Spudding Date 3-21-52

Drlg. Data Oil well TD 2323

15" @ 37 12" @ 247 10" @ 437

Anhy 758 8" @ 765 Tarkio 2306

7" @ 2306 TD 2323 CO to 2312 Hydro.

Comp. 25 bopd

J. G. McGEHEE