
FORM 51

Russell KANSAS

Section 26 Township 14 Range 14W

Well No. B-1 Krug

Company Trans-Era

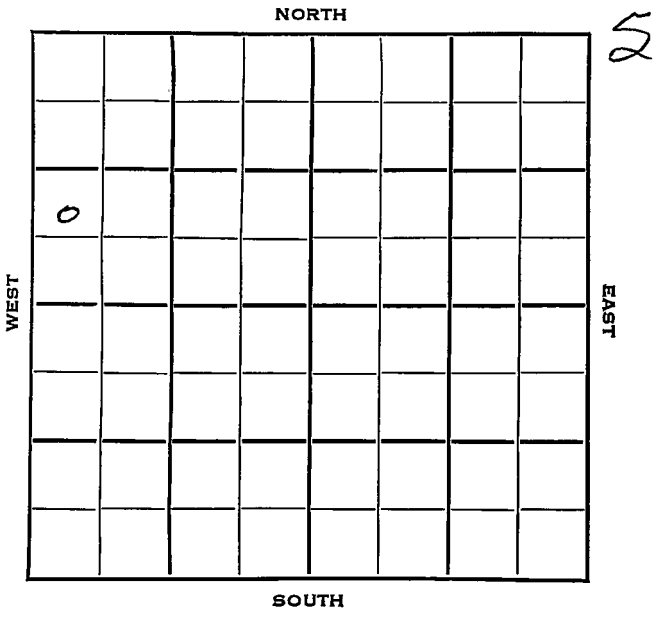

FORM 252-B

Russell

KANSAS ✓

Sec. 26 Twp. 14 R. 14 W

Well No. # B-1 Krug Farm

Trans-Era Company

Contractor


Ft. from N. Line

990 Ft. from S. Line

Ft. from E. Line

330 Ft. from W. Line

NW SW NW

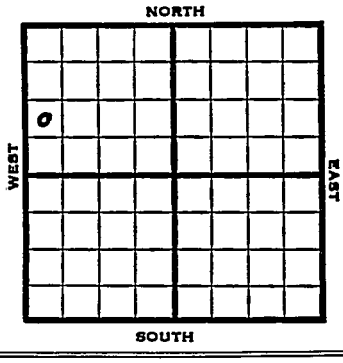

1952	Elev. 1796' REPORT
12/30	MIR
1/1	MIR
1/8	8" @ 230 Anhy 785 Ø2365
1/22	Tarkio 2319' Heeb 2873' Lans 2936' 5" @ 2518' RTD 3232' 24/2402-08 NS
1/29	NR
2/4	Spud 12-30-52 Oil well TD 3232' 8" @ 230 Anhy 785' Tarkio 2319' Heeb 2873' Lans. 2936' 5" @ 2518 TD 3232' 12/2404-08 SSO 9/2403-06 no inc. shut in 10 hr. B/wtr. 12/2362-64 24/2342-48 oil-frac. S/4 BO 3 BWPH SP 2388 S/2 BFPH 60% wtr. CO to 2377 16/2343-47 oil-frac. no help CO to 2472 4 BFPH 3/4 wtr. SP 2334 24/2318-22 SO & G S/2 BFP 30% wtr. DP 2465 Comp. 25 BOPD

COMPLETED

FORM 275 FOR SALE BY KANSAS BLUE PRINT CO.


County Russell State Kansas

Sec. 26 (Blk. Twp.) 14 (Sur. Rge.) 14W Map No.

Operator Trans-Era

Well No. B-1 Farm Krug

Elev. Location NW SW NW

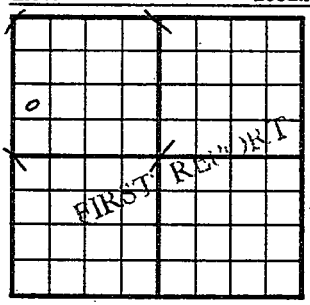

990 Ft. From S Line NW

330 Ft. From W Line Quarter

1st. Report DEC 30 1952

Completion

Remarks

Spudding Date

Drlg. Data

MIR

J. G. McGEHEE

FORM 275 FOR SALE BY KANSAS BLUE PRINT CO.


County Russell State Kansas

Sec. 26 (Blk. Twp.) 14 (Sur. Rge.) 14W Map No.

Operator Trans-Era

Well No. B-1 Farm Krug

Elev. 1796 Location NW SW NW

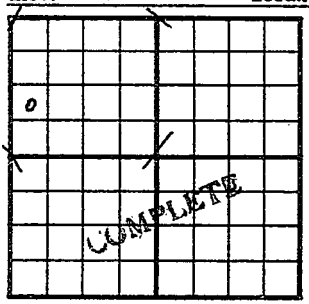

990 Ft. From S Line NW

330 Ft. From W Line Quarter

1st. Report

Completion FEB 4 1953

Remarks

Spudding Date 12-30-52

Drlg. Data Oil well TD 3232

8" @ 230 Anhy 785 Tarkio 2319

Heeb. 2873 Lans. 2936 5" @ 2518

TD 3232 12/ 2404-08 SSO 9/ 2403-06

no inc. shut in 10 hr. B/ wtr.

12/ 2362-64 24/ 2342-48 oil-frac

S/ 4 bo 3 bwph SP 2388 S/ 2 bfph

60% wtr. CO to 2377 16/ 2343-47

oil-frac no help CO to 2472

4 bfph 3/4 wtr. SP 2334 24/ 2318-22

SO & G S/ 2 bfph 30% wtr. DP 2465

Comp. 25 bopd

J. G. McGEHEE