


Section 26 Township 14 Range 14-W

Well No. #3 Boxberger

Company ^{Sohio}~~Central~~ Pet.

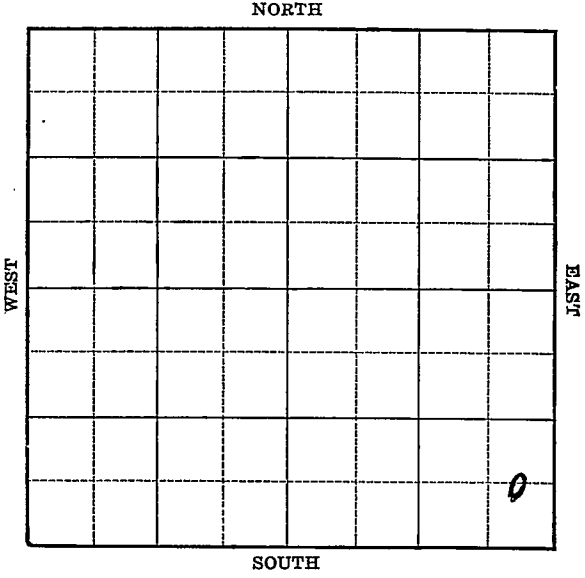

1940

6/19

Lans. 2914'

6" - 2914'

T.D. 2997'

8000 acid.

Bomb potential 3000 bbis.

COMPLETED

1951

8/15

O. W. D. D

KC 2914'

OTD 2997'

6" @ 2914'

DD 3031'

9/12

Oil well

TD 3112'

KC 2914'

OTD 2997'

6" @ 2914'

DD 3031'

DD 3154'

CO to 3150'

16/3142-46

10/3135-38

1 GFPH

500 A

3 GOPH

8/3090-92

6/3094-95

4 GO

1000 A

SP 3112'

1000 A

B/483 BFPH

DC 3154'

P/13 BO

57 BWPD

P/10 BO 24 BW 18 hr.

P/5 BOPD

32 BW

Comp. 13 BOPD

57 BW

COMPLETED

Map No. 72 Sec. 26 Twp. 14 R. 14WWell No. 3 BoxbergerCentral Petroleum

Company

Contractor

FIRST REPORT

C E L S E S E

_____ Ft. from N. Line

660 Ft. from S. Line330 Ft. from E. Line

_____ Ft. from W. Line

SECTION PLAT

| | | | |
|--|--|--|---|
| | | | |
| | | | |
| | | | |
| | | | o |

GURNEY POOL

Location _____

Rig up _____

Drilling and Remarks:

Cable**RECORD**

Cased _____ in., _____ ft.

Sand _____

Gas _____

Oil _____

Total Depth _____

PRODUCTION

1st 24 hrs. Nat. _____

1st 24 hrs. after shot _____

Gas _____ Cu. Ft.

Dry Hole _____

Abandoned _____

Date

APR 3 1940

19

S. J. LEWIS Scout

Misc Small Maps *RM*
Cards *RM*
Tracing *JWP*
France Map *JWP*
Scarborough Map *JWP*
Woodsy Map *JWP*
Geological Dept
Meadow Book

Map No. 72 Sec. 26 Twp. 14 R. 14^WWell No. 3 BoxbergerCentral Petroleum

Company

Contractor

COMPLETED

C E L S E S E

_____ Ft. from N. Line

660 Ft. from S. Line330 Ft. from E. Line

_____ Ft. from W. Line

GURNEY POOL

SECTION PLAT

| | | | |
|--|--|--|---|
| | | | |
| | | | |
| | | | |
| | | | 0 |

Location _____

Rig up _____

Drilling and Remarks:

*Law 2914**6" @ 2914**8000 Acid**Bom & P & 3000***RECORD**

Cased _____ in., _____ ft.

Sand _____

Gas _____

Oil _____

Total Depth: 2992**PRODUCTION**

1st 24 hrs. Nat. _____

1st 24 hrs. after shot _____

Gas _____ Cu. Ft.

Dry Hole _____

Abandoned _____

Date

JUN 19 1940 19S. J. LEWIS Scout

Misc Small Maps

Cards

Tracing

France Map

Scarborough Map

Moody Map

Geological Dept.

Moody Flat Book

County Russell State Kansas

Sec. 26 (Blk. Twp.) 14 (Sur. Rge.) 14W Map No.

Operator Sohio (was Central Pet.)

Well No. 3 Farm Boxberger

Elev. 1757 Location C E L S E S E

| | | | | | |
|--|--|--|--|--|--|
| | | | | | |
| | | | | | |
660 Ft. From S Line SE
330 Ft. From E Line Quarter

1st. Report AUG 15 1951

Completion _____

Remarks O.W.D.D.

O.W.D.D.

Spudding Date _____

Drig. Data Hall-Gurney Pool

KC 2914 OTD 2997 6" @ 2914

DD 3031

AUG 21 1951

| | |
|----------------|-----------|
| Scout Cards | <u>mm</u> |
| Land Small Map | |
| Land Wall Map | <u>27</u> |
| Tracings | |
| France Map | |
| Pierce Map | |
| Misc. | |

Drig. Data

County Russell State Kansas

Sec. 26 (Blk. 14) (Sur. 14W) (Twp.) 14 Map No.

Operator Sohio (was Central Pet.)

Well No. 3 Farm Boxberger

Elev. 1757 Location C E L SE SE

| | | | | | |
|--|--|--|--|--|--|
| | | | | | |
| | | | | | |
COMPLETE

660 Ft. From S Line SE

330 Ft. From E Line Quarter

1st. Report

Completion SEP 12 1951

Remarks OWDD

Spudding Date

Drig. Data Oil well TD 3112

KC 2914 OTD 2997 6" @ 2914 DD 3031

DD 3154 CO to 3150 16/ 3142-46

10/ 3135-38 1 gfph 500 A 3 goph

8/ 3090-92 6/ 3094-95 4 go 1000 A

SP 3112 1000 A B/ 483 bfph DC 3154

P/ 13 bo 57 bwpd P/ 10 bo 25 bw 18 hr.

Comp/ 5 bopd 32 bw

Comp. 13 bopd. 57 bw

J. E. TYRA

SEP 19 1951

Scout Cards 27
Land Small Map
Land Wall Map 57
Tracings
France Map
Pierce Map
Misc

Drig. Date