

KANSAS


Form 51-5M-7-40-Palace

Russell

Section 26 Township 14 Range 14-W

Well No. ~~#5~~ Boxberger #4

Company Central Petroleum

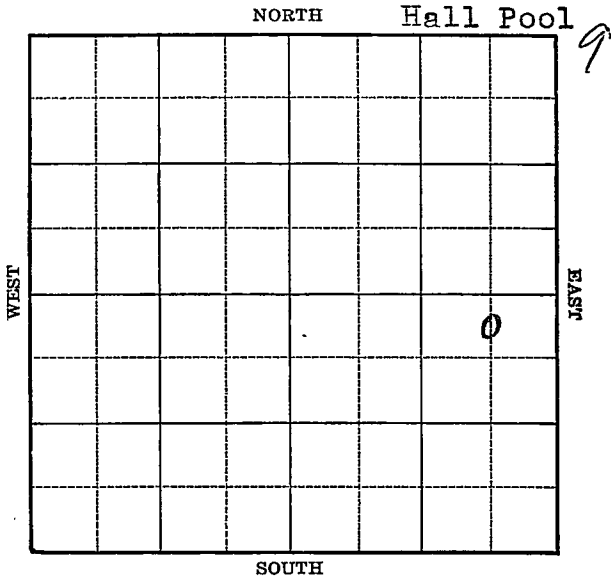

Sec. 26 Twp. 14 R. 14-W

Well No. #5 Boxberger #4 Farm

Central Petr.

Company

(Hall)


330 Ft. from N. Line

Ft. from S. Line

660 Ft. from E. Line

Ft. from W. Line

Elev. 1768

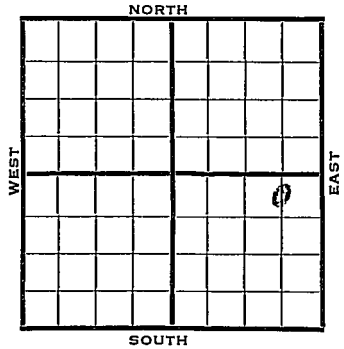

1940	REPORT
8/7	Location .
8/14	Cable rig.
8/22	" "
8/29	Spud 205'
9/5	12" - 460' Anhy 723'
	10" - 736' Drlg. 1310'
9/12	Show gas 1530' Drlg. 2245'
9/19	Gas 2264-70' Gas 2285'
	8" - 2425' S.O. 2670-75'
	Drlg. 2675'
9/26	Dodge 2852' Lans. 2897'
	6" - 2897' Drlg. 2935'
	250' oil 4 hours.
10/2	Lans. 2897'
	6" - 2922'
	T.D. 3000'
	8000 acid.
	Potential 2553 bbls., pump.
	COMPLETED

Map No. 72 Sec. 26 Twp. 14 R. 14W

Well No. 5 Boxberger

Central Petroleum Company

Contractor

FIRST REPORT

C N L NE SE

SECTION PLAT

330 Ft. from N. Line

_____ Ft. from S. Line

660 Ft. from E. Line

_____ Ft. from W. Line

			o

HALL POOL

Location X

Rig up _____

Drilling and Remarks:

RECORD

Cased _____ in., _____ ft.

Sand _____

Gas _____

Oil _____

Total Depth _____

PRODUCTION

1st 24 hrs. Nat. _____

1st 24 hrs. after shot _____

Gas _____ Cu. Ft.

Dry Hole _____

Abandoned _____

Date

AUG 7 1940 19

S. J. LEWIS Scout

Map No. _____ Sec. **26** Twp. **14** R. **14W**

Well No. **4 Boxberger**

Central Petroleum Company

CORRECTION Contractor

C N L N E S E

330 Ft. from N. Line

_____ Ft. from S. Line

660 Ft. from E. Line

_____ Ft. from W. Line

HALL POOL

SECTION PLAT

			o

Location _____

Rig up _____

Drilling and Remarks:

Reported as

#5 Boxberger

RECORD

Cased _____ in., _____ ft.

Sand _____

Gas _____

Oil _____

Total Depth _____

PRODUCTION

1st 24 hrs. Nat. _____

1st 24 hrs. after shot _____

Gas _____ Cu. Ft.

Dry Hole _____

Abandoned _____

Date

AUG 1 1940

S. J. LEWIS Scout

Map No. 72 Sec. 26 Twp. 14 R. 14W

Well No. 4 Boxberger

Central Petroleum Company

Contractor

COMPLETED

C N L N E S E

330 Ft. from N. Line

_____ Ft. from S. Line

660 Ft. from E. Line

_____ Ft. from W. Line

HALL POOL

SECTION PLAT

			o

Location _____

Rig up _____

Drilling and Remarks:

Loss 2897

6" @ 2922

8000 Acid

Pump. 2553 Pt.

RECORD

Cased _____ in., _____ ft.

Sand _____

Gas _____

Oil _____

Total Depth 3000

PRODUCTION

1st 24 hrs. Nat. _____

1st 24 hrs. after shot. _____

Gas _____ Cu. Ft.

Dry Hole _____

Abandoned _____

Date

OCT 2 1940 19

S. J. LEWIS Scout