


Section 26 Township 14 Range 14-W

Well Number 1 Boxberger

Company Hayes, Sackrider et al

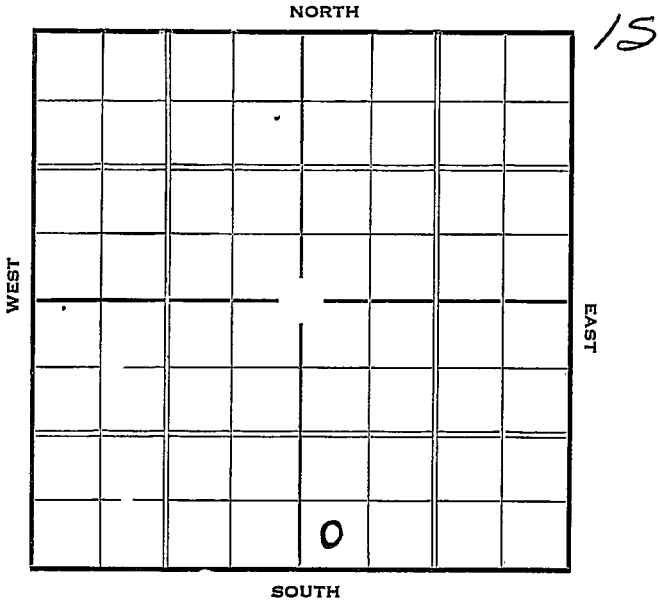

Sec. 26 Twp. 14 R. 14-W

Well No. #1 Boxberger Farm

Hayes, Sackrider et al Company


_____ Ft. from N. Line

330 Ft. from S. Line

_____ Ft. from E. Line

330 Ft. from W. Line

Elev. 1775

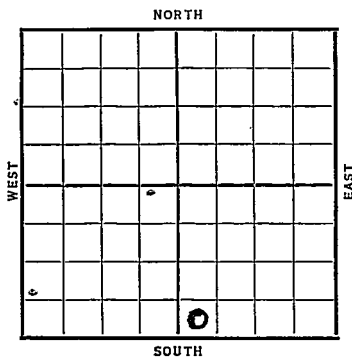

Date	REPORT
1937	
2/10	Location
2/19	Rig
2/26	Rigging up.
3/4	" "
3/11	" "
3/18	Shut Down.
3/25	" "
4/2	" "
4/8	15" @ 65'. Drlg. 295'
4/16	12" @ 442' Anhydrate 747'-10"
	@ 755'. Drlg. 760'
4/23	SD 1070'.
4/30	Drlg. 1655'.
5/7	Drlg. 2225'.
5/14	8" @ 2353'. Drlg. 2530'.
5/21	Drlg. 2890'.
5/28	" "
6/4	Osw. 2925'. S.O. 2937-39 &
	2945-50'. S.O. & G 2992-96
	T.D. 3005'. Rng. 6".
	OVER

1937

6/11 6" @ 2928'. T.D. 3019'.

Swab' 2½ bbls. per hr.

6/19 Drlg. 3157'.

6/25 Granite wash 3207' T.D.

P.B. 3010'. 6000 acid.

6/30 6" @ 2928'.

Oswald 2925'.

T.D. 3207'.

P.B. 3010'.

6000 acid.

Pot. 1103 bbls.

COMPLETED

KANSAS

Map No. _____ Sec. 26 Twp. 14 R. 14W


Contractor

SECTION PLAT

_____ Ft. from N. Line

330 Ft. from S. Line

_____ Ft. from E. Line

330 Ft. from W. Line

FIRST REPORT

Location ✓

Rig up _____

Drilling and Remarks:

RECORD

Cased _____ in., _____ ft.

Sand _____

Gas _____

Oil _____

Total Depth _____

PRODUCTION

1st 24 hrs. Nat. _____

1st 24 hrs. after shot _____

Gas _____ Cu. Ft.

Dry Hole _____

Abandoned _____

Date

1937

19

S. J. LEWIS Scout



Russell KANSAS

Map No. _____ Sec. 26 Twp. 14 R. 14^w

Well No. 1 - Boxberger

Hayes, Sackrider et al Company

Contractor

COMPLETED

SECTION PLAT

_____ Ft. from N. Line

330 Ft. from S. Line

_____ Ft. from E. Line

330 Ft. from W. Line

Location _____

Rig up _____

Drilling and Remarks:

P.B. 3010

6000 Acid

Post - 1103

RECORD

Cased 6 in., 2928 ft.

Sand Oswald 2925

Gas _____

Oil _____

Total Depth 3207

PRODUCTION

1st 24 hrs. Nat. _____

1st 24 hrs. after shot _____

Gas _____ Cu. Ft.

Dry Hole _____

Abandoned _____

Date

JUN 30 1937 19

I. field

Scout

RAY

Returned _____

Cards _____

Tracing _____

France Map _____

Scarborough Map _____

Moody Map _____

Scarborough Plat Book _____

Moody Plat Book _____

Paul
Joe
RAY