


Map No. KANSAS Sec. 26 Twp. 14 R. 14<sup>th</sup>

Well No. 1-Bohberger Farm

Hartman & Blair Company

*Russell*

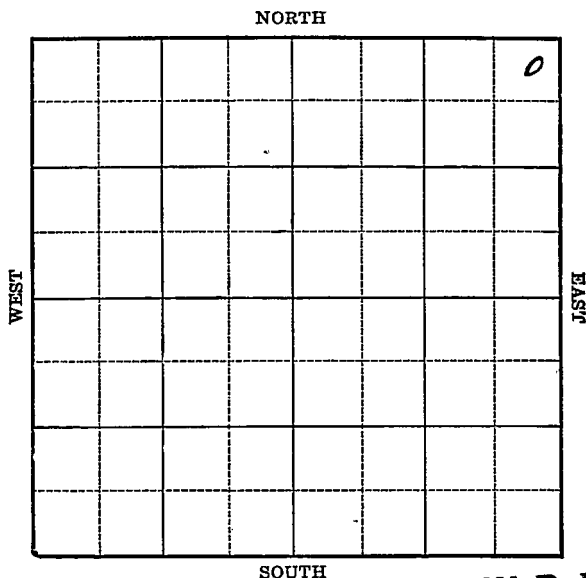

**O. W. D. D**

Location \_\_\_\_\_

Drilling Remarks

\_\_\_\_\_

\_\_\_\_\_

Rig Up \_\_\_\_\_

Drilling Remarks

\_\_\_\_\_

\_\_\_\_\_

**RECORD**

Cased \_\_\_\_\_ in. \_\_\_\_\_ ft.

Sand \_\_\_\_\_

Gas \_\_\_\_\_

Oil \_\_\_\_\_

Total Depth \_\_\_\_\_

**PRODUCTION**

1st 24 hrs. Nat. \_\_\_\_\_

1st 24 hrs. after shot \_\_\_\_\_

Gas \_\_\_\_\_ cu. ft.


Dry Hole \_\_\_\_\_

Abandoned \_\_\_\_\_

Russell

Map No. KANSAS Sec. 26 Twp. 14 R. 14W  
Well No. 1 Boyberger Farm  
Hartman & Blair Company

330 Ft. from N. Line  
       Ft. from S. Line  
330 Ft. from E. Line  
       Ft. from W. Line

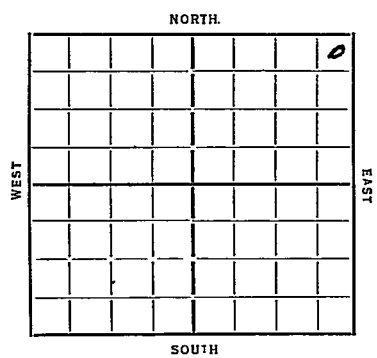

| Date | REPORT               | O. W. D. D |
|------|----------------------|------------|
| 1935 |                      |            |
| 3/20 | Location             |            |
| 3/28 |                      |            |
| 4/4  | Moving               |            |
| 4/14 | Rig                  |            |
| 4/18 | Spuds                |            |
| 4/26 |                      |            |
| 5/2  | 15" 283              | 12" 435    |
| 5/9  | dy 1050              | 10" 860    |
| 5/16 | sg 1680-90           | sg 2080    |
|      | dy 2085              |            |
| 5/23 | " 2250               | 8" 2120    |
| 5/29 | " 2455               |            |
| 6/6  | U R 8" 2495          |            |
| 6/13 | dy 2505              | 8" 2431    |
| 6/20 |                      |            |
| 6/28 | 8" 2481 T Topok 2640 |            |
|      | dy 2653              |            |
| 7/3  | dy 2930              | so 2710    |
| 7/11 | K R 2934 W. 2976     |            |
|      | dy 3010-12           | 6" 3006    |
|      | 100 oil Tubg         |            |
|      |                      | (OVER)     |

7/18 Pump 148 Bbls 12 hrs  
seru 6" 3006  
dly plug

8/8 S.D.

8/15 — 8/22 — 8/29 — 9/6 — 10/3 —  
10/10 —

11/1 Testing

11/7 pumped 50 Oil w/s  
24 hrs.

11/14 3000 acid  
pumped 227 Oil 18 hrs.

11/21 18 Bbls per hr after acid

11/29 — 12/6 — 12/13 —

12/19 S.D.

12/26 — 1/2/36 —

1/8 KC 2934 TD 3012

Pay 3010-12

3000 acid

414 Oil.

COMPLETED

O. W. D. D

1936

11/25 Old T. D. 3012'.

New T. D. 3017'.

Pot. 359'.

FIRST REPORTS

*and*

COMPLETED

KANSAS

Map No. 72 Sec. 26 Twp. 14 R. 14W

Well No. 1 - Bosherger

Hartman & Blair Company

Contractor

SECTION PLAT

330 Ft. from N. Line

..... Ft. from S. Line

330 Ft. from E. Line

..... Ft. from W. Line

COMPLETED

|  |  |  |   |
|--|--|--|---|
|  |  |  | 0 |
|  |  |  |   |
|  |  |  |   |
|  |  |  |   |
|  |  |  |   |

Location.....

Rig up.....

Drilling and Remarks:

*pay 3010-12*

*414 oil*

*after 3000 and*

RECORD

Cased..... in., ..... ft.

Sand KC 2934

Gas.....

Oil.....

Total Depth 3012

PRODUCTION

1st 24 hrs. Nat.....

1st 24 hrs. after shot.....

Gas..... Cu. Ft.

Dry Hole.....

Abandoned.....

Date

JAN 8 1936

192 ORVAL MANNSCHRECK Sco

Map No. 72 Sec. 26 Twp. 14 R. 14W

Well No. 1-Bosberger

Hartman & Blair Company

Contractor

## SECTION PLAT

**330** **FIRST REPORTS**  
Ft. from N. Line

Ft. from S. Line

**330** Ft. from E. Line

Ft. from W. Line

|  |  |  |   |
|--|--|--|---|
|  |  |  | ① |
|  |  |  |   |
|  |  |  |   |
|  |  |  |   |
|  |  |  |   |

Location ✓

Rig up

Drilling and Remarks:

## RECORD

Cased \_\_\_\_\_ in., \_\_\_\_\_ ft.

Sand \_\_\_\_\_

Gas \_\_\_\_\_

Oil \_\_\_\_\_

Total Depth \_\_\_\_\_

## PRODUCTION

1st 24 hrs. Nat. \_\_\_\_\_

1st 24 hrs. after shot \_\_\_\_\_

Gas \_\_\_\_\_ Cu. Ft.

Dry Hole \_\_\_\_\_

Abandoned \_\_\_\_\_

Date

3-20-35 192 ORVAL MANNSCHRECK Scout

Map No. 322 Sec. 26 Twp. 14 R. 14W.

Well No. Box 8298

Hartman & Blair Company

Contractor

**TEST REPORTS**

**SECTION PLAT**

|  |  |  |   |
|--|--|--|---|
|  |  |  | 0 |
|  |  |  |   |
|  |  |  |   |
|  |  |  |   |

330 Ft. from N. Line

\_\_\_\_\_ Ft. from S. Line

330 Ft. from E. Line

\_\_\_\_\_ Ft. from W. Line

**COMPLETED**

Oil

Location \_\_\_\_\_

Rig up \_\_\_\_\_

Drilling and Remarks:

Oil 3012

Pat 359

**RECORD**

Cased \_\_\_\_\_ in., \_\_\_\_\_ ft.

Sand \_\_\_\_\_

Gas \_\_\_\_\_

Oil \_\_\_\_\_

Total Depth 3012

**PRODUCTION**

1st 24 hrs. Nat. \_\_\_\_\_

1st 24 hrs. after shot \_\_\_\_\_

Gas \_\_\_\_\_ Cu. Ft.

Dry Hole \_\_\_\_\_

Abandoned \_\_\_\_\_

Date

NOV 25 1936

S. J. LEWIS

Scout