
KANSAS Russell

FORM 51 5M 4-41 PETROL

Section 26 Township 14 Range 15-W

Well No. #1 Wadby

Company Palmer Oil

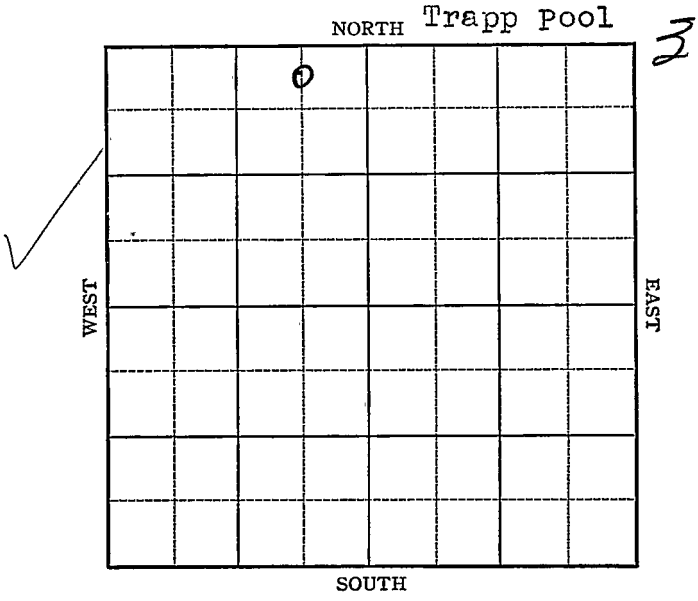

FORM 252-A 5M 1-41 PETROL KANSAS Russell

Sec. 26 Twp. 14 R. 15-W

Well No. #1 Wadby Farm

Palmer Oil Company


(Trapp)

~~660~~ 330 Ft. from N. Line

Ft. from S. Line

~~660~~ 660 Ft. from E. Line

Ft. from W. Line

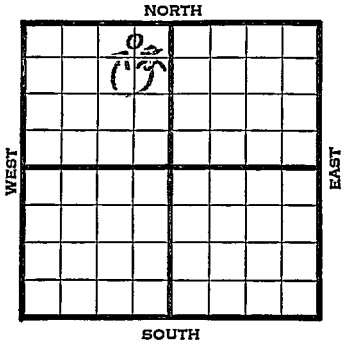

1941	REPORT
5/21	8" - 812'
	Drlg. 2000'
5/28	Gorham 3194-97' T.D.
	5" - 3194' RUST.
6/4	Gorham 3194'
	5" - 3194'
	T.D. 3202'
	Potential 409 bbls., pump.
	32.6 Gravity
	COMPLETED

Form 26—200 Bks.—1-40—Palace Russell KANSAS


Map No. 72 Sec. 26 Twp. 14 R. 15W

Well No. 1 Wadby

Palmer Oil Company

FIRST REPORT Contractor

SECTION PLAT

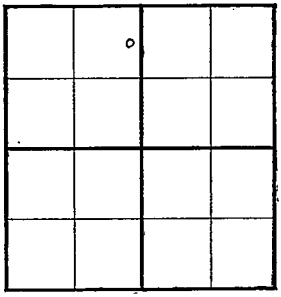

C E L NE NW

660 Ft. from N. Line

_____ Ft. from S. Line

330 Ft. from E. Line

_____ Ft. from W. Line

TRAPP POOL

Location _____

Rig up _____

Drilling and Remarks:

8" - 812

Drlg. 2000

RECORD

Cased _____ in., _____ ft.

Sand _____

Gas _____

Oil _____

Total Depth _____

PRODUCTION

1st 24 hrs. Nat. _____

1st 24 hrs. after shot _____

Gas _____ Cu. Ft.

Dry Hole _____

Abandoned _____

Date

MAY 21 1941 19

S. J. LEWIS Scout

Form 26—200 Bks.—1-40—Palace

Russell KANSAS

Map No. 72 Sec. 26 Twp. 14 R. 15W

Well No. 1 Wadby

Palmer Oil Company

CORRECTION Contractor

C N L NE NW

330 Ft. from N. Line


_____ Ft. from S. Line

660 Ft. from E. Line

_____ Ft. from W. Line

TRAPP POOL

SECTION PLAT

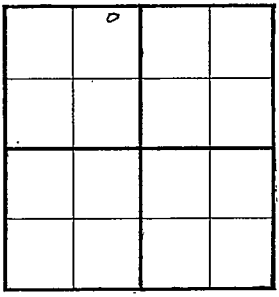

Location _____

Rig up _____

Drilling and Remarks:

Reported

C E L NE NW

RECORD

Cased _____ in., _____ ft.

Sand _____

Gas _____

Oil _____

Total Depth _____

PRODUCTION

1st 24 hrs. Nat. _____

1st 24 hrs. after shot _____

Gas _____ Cu. Ft.

Dry Hole _____

Abandoned _____

Date

_____ 19 _____

S. J. LEWIS Scout

Form 26—200 Bks.—1-40—Palace Russell KANSAS

Map No. = Sec. 26 Twp. 14 R. 15W

Well No. 1 Wadby

Palmer Oil Company

COMPLETED Contractor

C N L NE NW

330 Ft. from N. Line


_____ Ft. from S. Line

660 Ft. from E. Line

_____ Ft. from W. Line

TRAPP POOL

SECTION PLAT

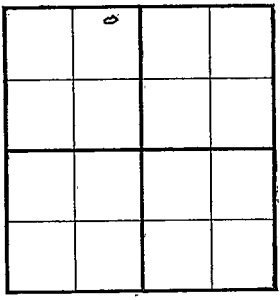

Location _____

Rig up _____

Drilling and Remarks:

Graham 3194

5" @ 3194

Pump 409 BF.

326 Gr

RECORD

Cased _____ in., _____ ft.

Sand _____

Gas _____

Oil _____

Total Depth 3202

PRODUCTION

1st 24 hrs.-Nat. _____

1st 24 hrs. after shot _____

Gas _____ Cu. Ft.

Dry Hole _____

Abandoned _____

Date

JUN 4 1941 19

S. J. LEWIS Scout