

# KANSAS

Form 51-5M-7-40-Palace


Russell

Section 26 Township 14 Range 14-W

Well No. #4 Boxberger

Company Hartman & Blair

NORTH Gurney Pool

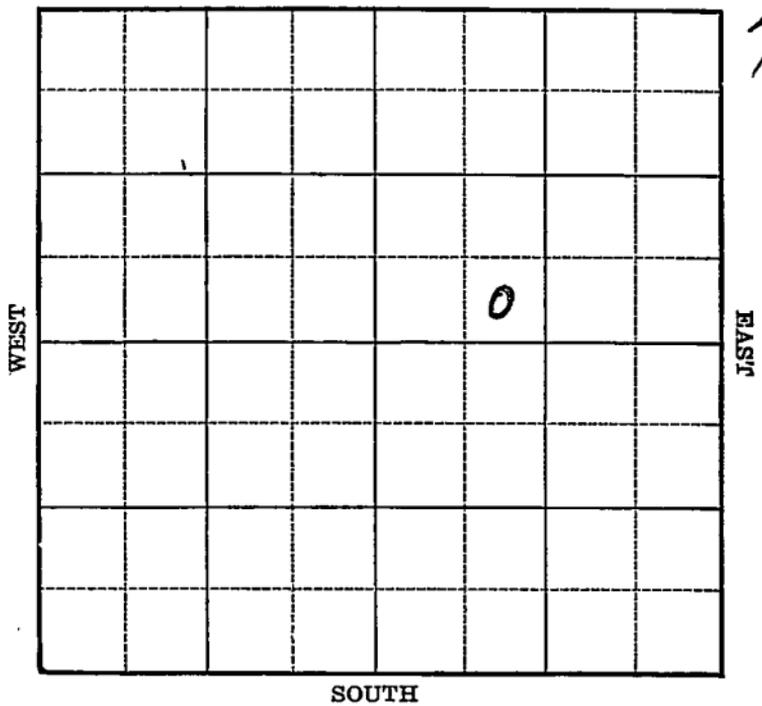

Sec. 26 Twp. 14 R. 14-W

Well No. #4 Boxberger Farm

Hartman & Blair Company

(Gurney)


\_\_\_\_\_ Ft. from N. Line

330 Ft. from S. Line

\_\_\_\_\_ Ft. from E. Line

990 Ft. from W. Line

Elev. 1775

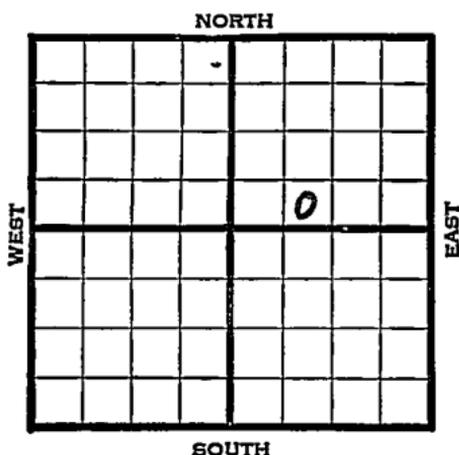

1940	REPORT
12/4	Cable .
12/12	Rigging up .
12/19	" "
12/26	" "
1941	
1/2	Rigging up . Shut down .
1/9	20" - 33' 15" - 280' Anhy 738' 10" - 751' 875' fsg. pipe .
1/16	Drlg. 1130'
1/23	Drlg. 2250'
1/30	Tarkio 2305' SSO 230.5-15' 8" - 2417' Topeka 2620' Drlg. 2675'
2/6	Lans. 2915' 7" - 2916' T.D. 2961' 2½ bailers oil per hour .
<b>OVER</b>	

1941  
2/12

Lans. 2915'  
7" - 2916'  
T.D. 3023'  
5000 acid.  
Pump & flow 3008 bbls.  
38. Gravity

COMPLETED

Map No. 72 Sec. 26 Twp. 14 R. 14WWell No. 4 BoxbergerHartman & Blair

Company

Contractor

**FIRST REPORT**

SE SW NE

\_\_\_\_\_ Ft. from N. Line

330 Ft. from S. Line

\_\_\_\_\_ Ft. from E. Line

990 Ft. from W. Line

GURNEY POOL

**SECTION PLAT**

		o	

Location \_\_\_\_\_

Rig up \_\_\_\_\_

Drilling and Remarks:  
Cable**RECORD**

Cased \_\_\_\_\_ in., \_\_\_\_\_ ft.

Sand \_\_\_\_\_

Gas \_\_\_\_\_

Oil \_\_\_\_\_

Total Depth \_\_\_\_\_

**PRODUCTION**

1st 24 hrs. Nat. \_\_\_\_\_

1st 24 hrs. after shot \_\_\_\_\_

Gas \_\_\_\_\_ Cu. Ft.

Dry Hole \_\_\_\_\_

Abandoned \_\_\_\_\_

Date

DEC 4 1940S. J. LEWIS Scout

Misc. Small Maps	<i>DAW</i>
Cards	<i>Paul</i>
Tracing	<i>JM</i>
France Map	<i>DAW</i>
ScarLan. 1911 Map	
Italy	<i>JM</i>
Geog. Dept.	
Map of Italy Book	

Map No. 72 Sec. 26 Twp. 14 R. 14W

Well No. 4 Boxberger

Hartman & Blair Company

Contractor

**COMPLETED**

**SECTION PLAT**

SE SW NE

\_\_\_\_\_ Ft. from N. Line

330 Ft. from S. Line

\_\_\_\_\_ Ft. from E. Line

990 Ft. from W. Line


GURNEY POOL

Location \_\_\_\_\_

Rig up \_\_\_\_\_

Drilling and Remarks:

*Lans 2915*

*7" @ 2916*

*5000 acid*

*Pump & Flow 3008*

*38<sup>th</sup> Hr.*

**RECORD**

Cased \_\_\_\_\_ in., \_\_\_\_\_ ft.

Sand \_\_\_\_\_

Gas \_\_\_\_\_

Oil \_\_\_\_\_

Total Depth 3023

**PRODUCTION**

1st 24 hrs. Nat. \_\_\_\_\_

1st 24 hrs. after shot \_\_\_\_\_

Gas \_\_\_\_\_ Cu. Ft.

Dry Hole \_\_\_\_\_

Abandoned \_\_\_\_\_

Date

FEB 12 1941 19

S. J. LEWIS Scout

2

Misc Small Maps	<i>DMJ</i>
Cards	<i>Paul</i>
Tracing	<i>DMJ</i>
France Map	<i>DMJ</i>
S	<i>DMJ</i>
Y Van	<i>DMJ</i>
* ... pt.	
... Re	