FORM 51 25M 3-49 PETROL


KANSAS

Russell

Section 26 Township 14S Range - 14W

Well No. #6 Boxberger

Company Central Pet. Co.

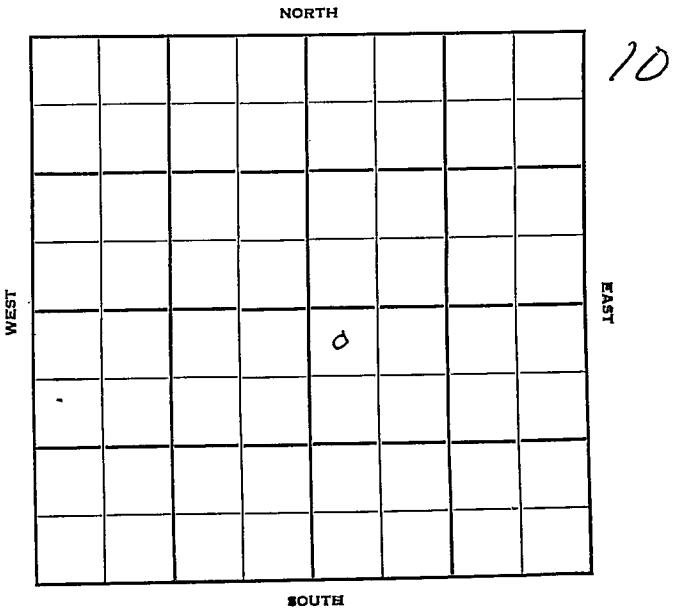

FORM 252-A
5M 10-48 PETROL

KANSAS Russell

Sec. 26 Twp. 14 R. 14-W

Well No. #6 Boxberger Farm

Central Pet. Company

Hall-Gurney Pool


330 Ft. from N. Line

Ft. from S. Line

Ft. from E. Line

330 Ft. from W. Line

NW SE

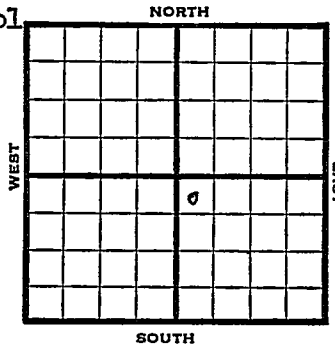

1949	Elev 1770' REPORT
10/5	Location
10/12	"
10/19	"
10/26	12" @ 40' Drlg. 800'
11/1	10" @ 445' 8" @ 755' Drlg. 1235'
11/9	Drlg. 2075'
11/16	7"@ 2115' Tarkio 2290? Drlg 2292 SSO
11/23	TD 2340 5"@ 2291'
11/29	TD 2358'
12/7	"
12/14	1 B oil PH
12/21	"
12/28	"
1950	
1/11	TD 2358' 12"@ 40' 10"@ 445' 8"@ 755' PP 2½ BOPD Comp

COMPLETED

Form 26 200 Bks. 6-49 Petrol

Kansas

Hall-Gurney Pool

Map No. Sec. 26 Twp. 14 R. 14W


Well No. 6 Boxberger

Central Pet. Company

Contractor

NW SW

FIRST REPORT
SECTION PLAT

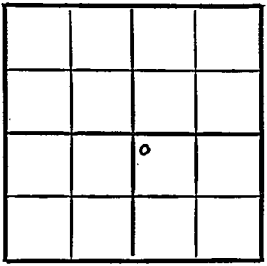

330 Ft. from N. Line

Ft. from S. Line

Ft. from E. Line

330 Ft. from W. Line

Russell County

Location X

Rig up

Drilling and Remarks:

RECORD

Cased in., ft.

Sand

Gas

Oil

Total Depth

PRODUCTION

1st 24 hrs. Nat.

1st 24 hrs. after shot

Gas Cu. Ft.

Dry Hole

Abandoned

Date

OCT 5 1949 19

S. J. LEWIS Scout

Form 26 200 Bks. 6-49 Petrol

Kansas

Hall-Gurney

Map No. ____ Sec. 26 Twp. 14 R. 14W

Well No. 6 Boxberger

Central Pet. Company

Contractor

NW SE

Elv 1770


SECTION PLAT

330 Ft. from N. Line

Ft. from S. Line

Ft. from E. Line

330 Ft. from W. Line

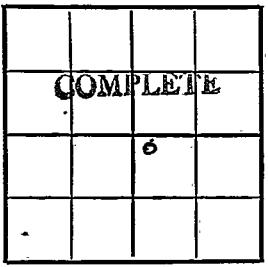

Russell County

Location

Rig up

Drilling and Remarks:

12" @ 40
10" @ 445
8" @ 755
PP 2½ BOPD

RECORD

Cased ____ in., ____ ft.

Sand

Gas

Oil

Total Depth 2358

PRODUCTION

1st 24 hrs. Nat.

1st 24 hrs. after shot

Gas ____ Cu. Ft.

Dry Hole

Abandoned

Date

JAN 11 1950 19

J. E. TYRA

Scout