

KANSAS

Form 51-5M-7-40-Palace

Russell


Section 26 Township 14 Range 14-W

Well No. #5 Boxberger

Company Landon et al

Gurney Pool

NORTH

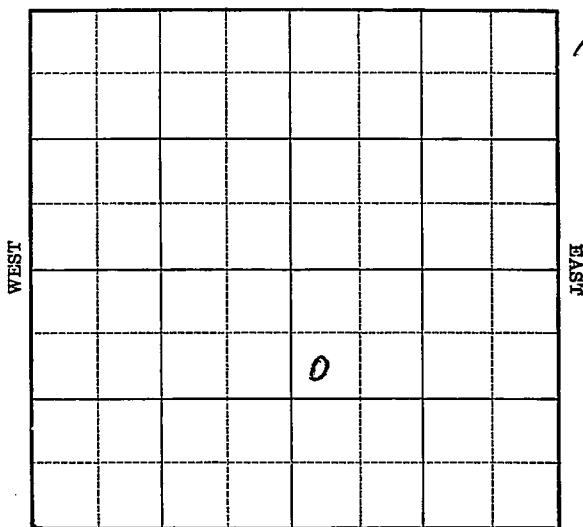

SOUTH

1941
2/5

Lans. 2897'

7" - 2897'

T.D. 3013'

8000 acid.

Depthograph potential 18,800 bbl

Maximum 3000 bbls.

38.3 Gravity

COMPLETED

Map No. 72 Sec. 26 Twp. 14 R. 14WWell No. 5 Boxberger
Landon etal Company

Contractor

FIRST REPORT

SW NW SE

990 Ft. from N. Line

_____ Ft. from S. Line

_____ Ft. from E. Line

330 Ft. from W. Line

GURNEY POOL

SECTION PLAT

Location _____

Rig up _____

Drilling and Remarks: _____

Pits

RECORD

Cased _____ in., _____ ft.

Sand _____

Gas _____

Oil _____

Total Depth _____

PRODUCTION

1st 24 hrs. Nat. _____

1st 24 hrs. after shot _____

Gas _____ Cu. Ft.

Dry Hole _____

Abandoned _____

Date

OCT 23 1940 19

S. J. LEWIS Scout

Misc Small Maps	<i>JMS</i>
Cards	<i>Handwritten</i>
Tracing	<i>JMS</i>
France Map	<i>JMS</i>
Scarborough Map	<i>JMS</i>
Moody Map	<i>JMS</i>
Geological Dept.	
Moody Flat Book	

Map No. 72 Sec. 26 Twp. 14 R. 14W

Well No. 5 Boxberger

Landon etal Company

~~CONFIDENTIAL~~ Contractor

SECTION PLAT

SW NW SE

990 Ft. from N. Line

_____ Ft. from S. Line

_____ Ft. from E. Line

330 Ft. from W. Line

		6	

GURNEY POOL

Location _____

Rig up _____

Drilling and Remarks:

Case 2897
7" @ 2897
8000 acid
Depth 2815800
Max 3000
38.3 hr.

RECORD

Cased _____ in., _____ ft.

Sand _____

Gas _____

Oil _____

Total Depth 3013

PRODUCTION

1st 24 hrs. Nat. _____

1st 24 hrs. after shot _____

Gas _____ Cu. Ft.

Dry Hole _____

Abandoned _____

Date

FEB 5 1941 19

S. J. LEWIS Scout

Misc. Small Maps
Cards
Tracing
France Map
Scarborough Map
Moody Map
Geological Dept.
Moody Flat Book