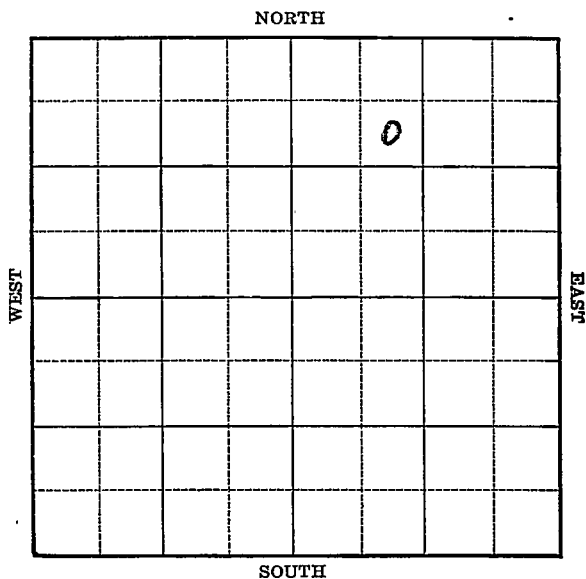



Section 26 Township 14 Range 14-WWell No. #5 BoxbergerCompany Hartman & Blair

Sec. 26 Twp. 14 R. 14 -WWell No. #5 Boxberger FarmHartman & Blair Company

(Hall Gurney)

990 Ft. from N. Line Ft. from S. Line Ft. from E. Line990 Ft. from W. Line

Elev. 1791

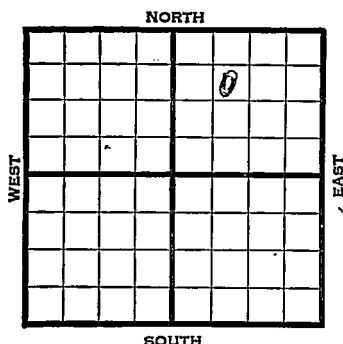

194 1

REPORT

2/12 Cable.

2/20 Spud.

2/27 20" - 25' 15" - 285'

12" - 469' 10" - 752'

Anhy 752' Drlg. 1440'

3/6 Drlg. 2355'

3/10 8" - 2436' SS0 2865'

Dodge 2885' Lans. 2935'

7" - 2940' SS0 2950-55'

T.D. 2973' S.O. C.O.

3/20 Granite wash 3181'

T.D. 3221' No shows.

3/27 " " " "

OVER

1941

4/2

Lans. 2935'

5" - 29 40'

Granite 3311'

T.D. 3321'

P.B. to 3036'

9000: acid.

Potential 41.6 bbls., pump.

38. Gravity

COMPLETED

Map No. 72 Sec. 26 Twp. 14 R. 14WWell No. 5 BoxbergerHartman & Blair CompanyFIRST REPORT Contractor

SE NW NE

990 Ft. from N. Line Ft. from S. Line Ft. from E. Line990 Ft. from W. Line

SECTION PLAT

HALL GURNEY POOL

Location Rig up

Drilling and Remarks:

Cable

RECORD

Cased in., ft.Sand Gas Oil Total Depth

PRODUCTION

1st 24 hrs.-Nat. 1st 24 hrs. after shot Gas Cu. Ft.Dry Hole Abandoned

Date

FEB 12 1941 19

S. J. LEWIS Scout

Misc. Small Maps

Cards

Tracing

France Map

Scarborough Map

Moody Map

Geological Dept.

Moody Flat Book

Map No. 72 Sec. 26 Twp. 14 R. 14WWell No. 5 BoxbergerHartman & Blair CompanyCOMPLETED Contractor

SECTION PLAT

SE NW NE

990 Ft. from N. Line Ft. from S. Line Ft. from E. Line990 Ft. from W. Line

HALL GURNEY POOL

		o	

Location Rig up

Drilling and Remarks:

*Lane 2935**5" Q2940**Granite 3011**PB. 3036**9000 acd/c**Prof 416 P.Y.**35° Gr.*

RECORD

Cased in., ft.Sand Gas Oil Total Depth 3321

PRODUCTION

1st 24 hrs. Nat. 1st 24 hrs. after shot Gas Cu. Ft.Dry Hole Abandoned

Date

APR 2 1941₁₉

S. J. LEWIS Scout

Misc. Small Maps	<i>WMS</i>
Cards	<i>Paul</i>
Tracing	<i>JM</i>
France Map	<i>Paul</i>
Scamorough Map	<i>JM</i>
Gay Map	<i>JM</i>
Geological Dept.	
Print Look	