


Section 26 Township 14 Range 14W

Well No. #5 Boxberger

Company Central Petroleum

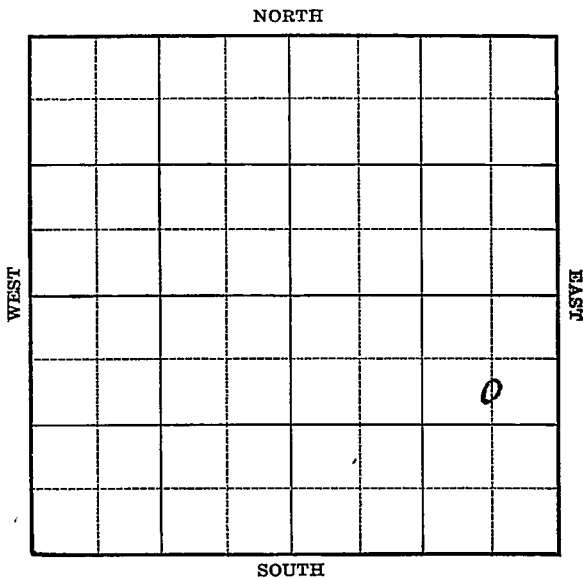



1940

12//4

Lans. 2895'

7" - 2917'

T.D. 3001'

8000 acid.

Depthograph potential 3038 bbls.

38. Gravity

COMPLETED





Map No. 72 Sec. 26 Twp. 14 R. 14W

Well No. 5 Roxberger

Central Petroleum Company

Contractor \_\_\_\_\_

**COMPLETED**

**SECTION PLAT**

C S L N E S E

990 Ft. from N. Line

\_\_\_\_\_ Ft. from S. Line

660 Ft. from E. Line

\_\_\_\_\_ Ft. from W. Line

			o

**GURNEY POOL**

Location \_\_\_\_\_

Rig up \_\_\_\_\_

Drilling and Remarks:

*Loss. 2895'*  
*7" C 2917.*  
*8000 acid*  
*Depth P & 3038*  
*38' Gr.*

**RECORD**

Cased \_\_\_\_\_ in., \_\_\_\_\_ ft.

Sand \_\_\_\_\_

Gas \_\_\_\_\_

Oil \_\_\_\_\_

Total Depth 3001

**PRODUCTION**

1st 24 hrs. Nat. \_\_\_\_\_

1st 24 hrs. after shot \_\_\_\_\_

Gas \_\_\_\_\_ Cu. Ft.

Dry Hole \_\_\_\_\_

Abandoned \_\_\_\_\_

Date

DEC 4 1940 19

S. J. LEWIS Scout

Misc. Small Maps.....  
Cards.....  
Tracing.....  
France Map.....  
Scarborough Map.....  
Goody Map.....  
C. Land Dept.....  
Woods Hat Book.....