
Form 51—5M—2-29—34703

Map No. KANSAS Sec. 26 Twp. 14 R. 14W

Well No. 1 Farm

Empire Oil Co Company

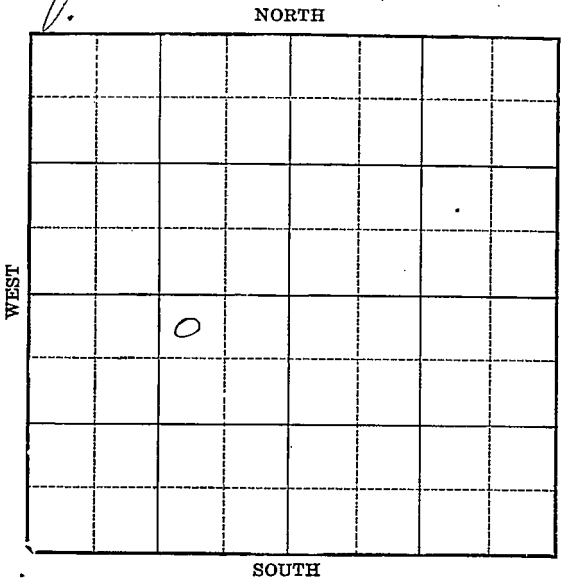

Location	Rig Up
Drilling Remarks	Drilling Remarks

RECORD		PRODUCTION	
Cased	in. ft.	1st 24 hrs. Nat.	
Sand		1st 24 hrs. after shot	
Gas		Gas	cu. ft.
Oil		Dry Hole	
Total Depth		Abandoned	

Form 252A—5M—11-29—38055 Russell

Map No. KANSAS Sec. 26 Twp. 14 R. 14W

Well No. 1 - Herbel Farm

Empire O&G Company


330 Ft. from N. Line

Ft. from S. Line

990 Ft. from E. Line

Ft. from W. Line

1930

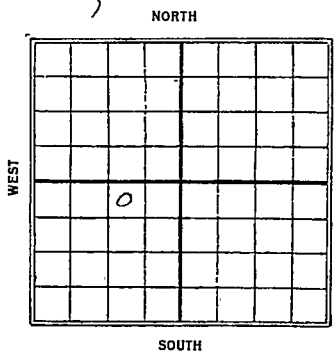

Date	REPORT
5/28	Loc.
6/4	Bldg. rig
6/11	Rigging up
6/18	
6/25	Spud
7/2	Drlg 490'
7/9	" 1010'
7/16	" 2025'
7/23	" 2395'
	show oil 2345'
7/30	8"- 2640' show
	oil 2655'
	Drlg 2840'
8/6	" 3261'
	6"- 3112' granite
	wash 3029'
8/13	Top Granite 3261
	TD 3323
	Dry & Abandon

Form 26—1M Blks. 9-28

Map No. KANSAS Sec. 26 Twp. 14 R. 14W

Well No. 1 Neese

Empire Oil & Ref. Company

Contractor

330 Ft. from N. Line


Ft. from S. Line

990 Ft. from E. Line

Ft. from W. Line

FIRST REPORTS

SECTION PLAT

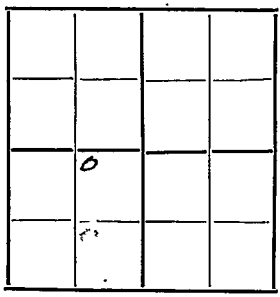

Location

Rig up

Drilling and Remarks:

R.O.G.

RECORD

Cased in., ft.

Sand

Gas

Oil

Total Depth

PRODUCTION

1st 24 hrs. Nat.

1st 24 hrs. after shot

Gas Cu. Ft.

Dry Hole

Abandoned

Date

MAY 28 1930

192

S. J. LEWIS Scout

Form 26—1M Bks.—2-29

Russell

Map No. KANSAS Sec. 26 Twp. 14 R. 14W


72

Well No. 1 Herbert

Empire Oil & Ref. Co. Company

Contractor

SECTION PLAT

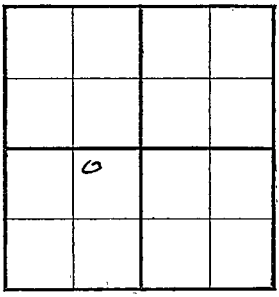

330 Ft. from N. Line

Ft. from S. Line

990 Ft. from E. Line

Ft. from W. Line

ABANDONED

Location

Rig up

Drilling and Remarks:

Top Granite 3261

RECORD

Cased in., ft.

Sand

Gas

Oil

Total Depth 3328

PRODUCTION

1st 24 hrs. Nat.

1st 24 hrs. after shot

Gas Cu. Ft.

Dry Hole

Abandoned

Date

AUG 13 1930 19

S. J. LEWIS Scout