

Section 27 Township 14 Range 16W

Well No. ~~E. M. Schulte~~ #3 Schulte

Company Atlantic Refg. Fred J. Haynes

NORTH

NW NE SE

WEST

EAST

						0	

SOUTH

Ellis KANSAS


SEC. 27 TWP. 14 R. 16W ✓

WELL NO. 1 E. M. Schulte FARM

COMPANY Atlantic Refg.

CONTRACTOR Lohman & Johnson  
SE Dreiling Pool

330 \_\_\_\_\_ Ft. from N. Line  
 \_\_\_\_\_ Ft. from S. Line  
 990 \_\_\_\_\_ Ft. from E. Line  
 \_\_\_\_\_ Ft. from W. Line

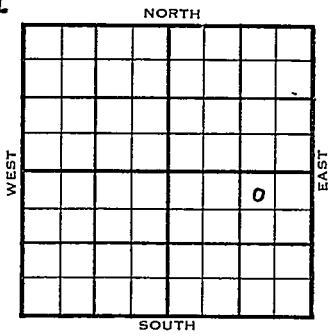

NW NE SE

1953 ELEVATION 1838' REPORT

12/9 MIR  
 12/16 8" @ 720'  
 Drlg. 2837'  
 12/22 Spud 12-8-53  
 D&A  
 TD 3395'  
 8" @ 720'  
 Heeb 3042', Tor 3064', Mans 3092'  
 DST 3095-3107', opn 1 hr., rec. 10'  
 mud, Off  
 Cong 3338'  
 DST 3335-60', opn 1 hr., rec. 20' mud,  
 10' socm, 235#  
 Arb. 3383'  
 TD 3395'  
 D&A

ABANDONED

County Ellis State Kansas

Sec. 27 (Blk. 14) (Sur. 16W) (Twp.) (Rge.) Map No.

Operator Atlantic Ref.

Well No. 1 Farm E. M. Schulte

Elev. \_\_\_\_\_ Location NW NE SE


*FIRST REPORT*

330 Ft. From N Line SE

990 Ft. From E Line Quarter

Ist. Report DEC 9 1953

Completion \_\_\_\_\_

Remarks \_\_\_\_\_

Lohman & Johnson - Contr.

Spudding Date \_\_\_\_\_

Drlg. Data SE Drilling Pool

**M I R**


County Ellis State Kansas

Sec. 27 (Blk.) 14 (Sur.) 16W Map No.

Operator Atlantic Ref.

Well No. 1 Farm E. M. Schulte

Elev. 1838 Location NW NE SE

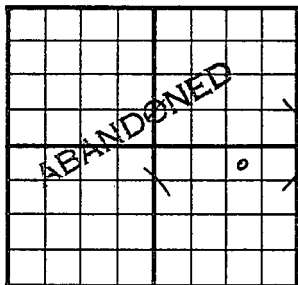

330 Ft. From N Line SE

990 Ft. From E Line Quarter

Ist. Report

Completion DEC 22 1953

Remarks SE Dreiling Pool

Lohman & Johnson - Contr.

Spudding Date 12-8-53

Drig. Data D & A TD 3395

8" @ 720 Heeb. 3042 Tor. 3064

Lans. 3092 DST 3095-3107 open 1 hr.

Rec. 10' mud 0# Cong. 3338

DST 3335-60 open 1 hr. Rec. 20' mud

10' socm 235# Arb. 3383 TD 3395

D & A

J. G. MCGEHEE

~~N.W.O.~~  
N.W.O.

S-513.A

CO. Ellis ELEV. 1841 RB  
SEC. 27 TWP. 14 RGE. 16W  
COMPANY Fred J. Haynes NO. 3

FIRST REPORT	

FARM Schulte  
LOC. NW NE SE

O.W.W.O.  
J.W.W.O.


GEOL. \_\_\_\_\_  
 CONTR. \_\_\_\_\_  
 POOL Dreiling SE  
 SPUD \_\_\_\_\_  
 \_\_\_\_\_  
 \_\_\_\_\_  
 \_\_\_\_\_  
 \_\_\_\_\_

Old Info. - was Atlantic #1 E.M. Schulte  
OTD 3395, D & A.  
New Info. - Co. Tools - MI to washover for  
SWDW

CO.  
LSE.  
NO.  
SEC.  
TWP.  
RGE.

