
FORM 51

Ellis KANSAS

Section 27 Township 14 Range 16 W

Well No. # 4 Berens

Company Transit Corp.

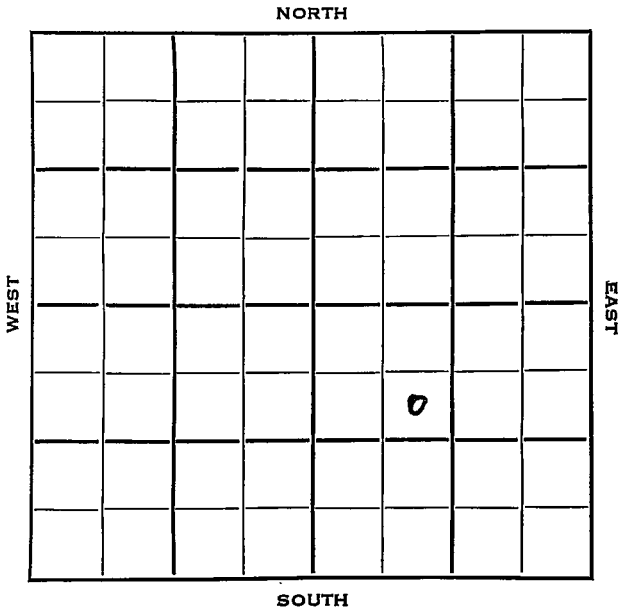

Ellis KANSAS

SEC.	TWP.	R.
27	14	16W

WELL NO.

#4 Berens FARM

COMPANY

Transit Corp

CONTRACTOR

Transit


SE Dreiling Pool

990 Ft. from N. Line

Ft. from S. Line

Ft. from E. Line

990 Ft. from W. Line

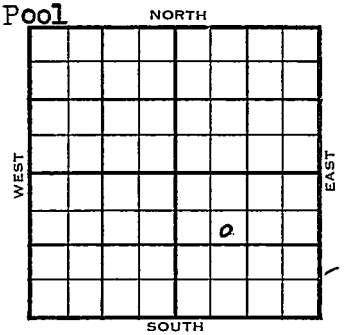

SE NW SE

	ELEVATION	
1953	1836'	REPORT
11/18	Spud 11-15-53 Anhy 1924' 8" @ 931' WOC	
12/16	WOC	
12/22	Spud 11-15-53 D&A TD 3353' Anhy 924' 8" @ 931' KC 3080' DST 3064-3100', opn 1 hr., rec. 90' muddy s w, 740# DST 3123-34', opn 1 hr., rec. 20' socm, 85# Arb. 3334' TD 3342' 5" @ 3336' CO to 3342' DD 3345', SSO, 500A DD 3352', 10 goph 500A DD 3353 1000A, wtr. 30/3337-47', dry 250 mud acid, frac, 5 bwph D&A	

ABANDONED

DX-78

FORM 275 FOR SALE BY KANSAS BLUE PRINT CO.


County Ellis State Kansas

Sec. 27 (Blk. Twp.) 14 (Sur. Rge.) 16W Map No.

Operator Transit Corp.

Well No. 4 Farm Berens

Elev. Location SE NW SE

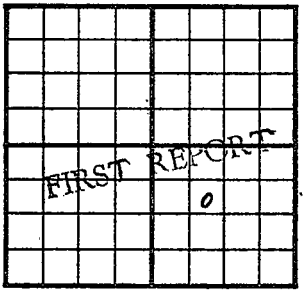

990 Ft. From N Line SE

990 Ft. From W Line Quarter

NOV 18 1953

1st. Report NOV 18 1953

Completion

Remarks

Transit - Contr.

Spudding Date 11-15-53

Drlg. Data SE Drilling Pool

Anhy 924 8" @ 931 WOC

J. G. McGEHEE

FORM 275 FOR SALE BY KANSAS BLUE PRINT CO.


County Ellis State Kansas

Sec. 27 (Blk. Twp.) 14 (Sur. Rge.) 16W Map No.

Operator Transit Corp.

Well No. 4 Farm Berens

Elev. 1836 Location SE NW SE

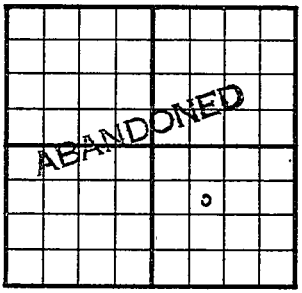

990 Ft. From N Line SE

990 Ft. From W Line Quarter

1st. Report

Completion DEC 22 1953

Remarks SE Dreiling Pool
Transit - Contr.

Spudding Date 11-15-53

Drlg. Data D & A TD 3353

Anhy 924 8" @ 931 KC 3080 DST 3064-3100
open 1 hr. Rec. 90' muddy sw 740#
DST 3123-34 open 1 hr. Rec. 20' socm
85# Arb. 3334 TD 3342 5" @ 3336
CO to 3342 DD 3345 SSO 500 A
DD 3352 10 goph 500 A DD 3353
1000 A wtr. 30/ 3337-43 dry 250
mud acid frac 5 bwph

D & A

J. G. McGEHEE