


Ellis

KANSAS

SECTION 27 TOWNSHIP 14S RANGE 16W

WELL NO. #1 Dreiling

COMPANY Keystone Petr.

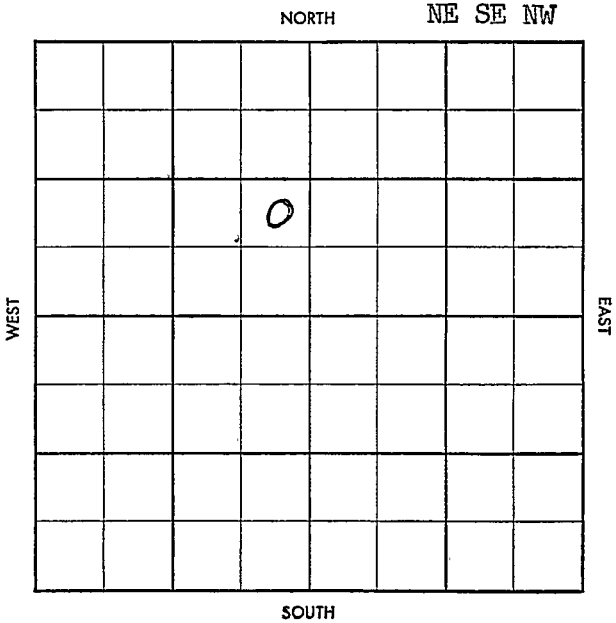

S-513-A

CO. ELMS ELEV. 18460

JAN 29 '58

0

SEC. 27 TWP. 14 RGE. 16W

COMPANY Keystone Pet. NO. 4

COMPLETE

FARM Dreiling

LOC. NE SE NW

GEOL. _____

CONTR. Haynes

POOL SE Dreiling

SPUD 10-15-57

Location 8" 940

10 2900

5 3350 CO

NOV 6 '57 DD 3383 (2)

FU 1700' oil' NW

12 hrs T & R

DEC 4 '57 DEC 7

DEC 26 '57

JAN 2 '58

JAN 8 '58

JAN 15 '58

JAN 22 '58

JAN 29 '58

25 Bwpd + 25 Bwpd

CO.

LSE.

NO.

SEC.

TWP.

RGE.

AC 3187
A+ 3338

TD 3350