

KANSAS

Ellis


FORM 51 IOM 12-46 PETROL

Section 27 Township 14 Range 16-W

Well No. 1 Drilling

Company H. H. Lutteral

Wildcat

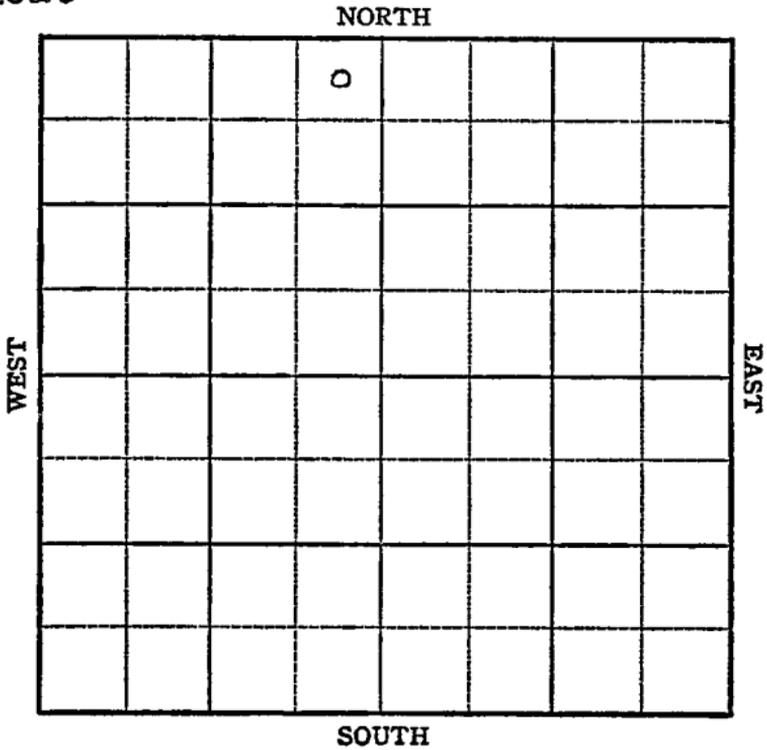

Ellis

Sec. 27 Twp. 14 R. 1 6W

Well No. #1 Dreiling Farm

H.H. Litterel Company

Wildcat


330 Ft. from N. Line

_____ Ft. from S. Line

330 Ft. from E. Line

_____ Ft. from W. Line

NE NW

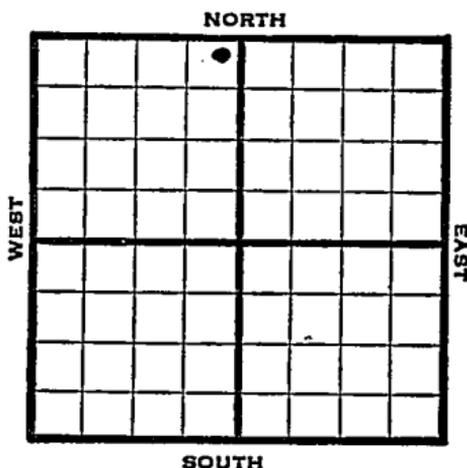

1947 Elev. 1847' REPORT

10/8 RUR

10/15 8" @ 226'
Anhydrate 950'
Drlg. 1175'

10/22 Drlg. 3050'

10/29 Arbuckle 3350'
PD 3412'

ABANDONED

Map No. _____ Sec. 27 Twp. 14 R. 16W

Well No. 1 Dreiling

H. H. Lutterel Company

FIRST REPORT Contractor

NE NW


SECTION PLAT

330 Ft. from N. Line

_____ Ft. from S. Line

330 Ft. from E. Line

_____ Ft. from W. Line

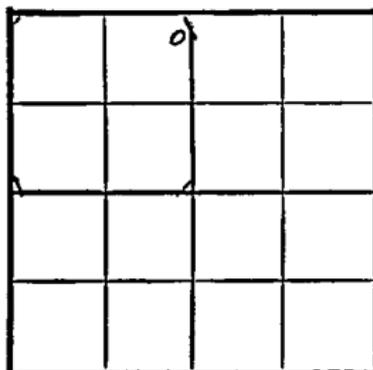

Ellis County

Location _____

Rig up _____

Drilling and Remarks:

R U R

RECORD

Cased _____ in., _____ ft.

Sand _____

Gas _____

Oil _____

Total Depth _____

PRODUCTION

1st 24 hrs. Nat. _____

1st 24 hrs. after shot _____

Gas _____ Cu. Ft.

Dry Hole _____

Abandoned _____

Date

OCT 8 1947 19 _____

S. J. LEWIS Scout

[Handwritten signature]

Small Maps	
Price	<i>Clare</i>
Feet	
Price Map	<i>1</i>
English Map	<i>1</i>
Map	
Local Dept.	
Price Flat Book	

Map No. 71 Sec. 27 Twp. 14 R. 16W

Well No. 1 Dreiling

H. H. Lutterel Company

ABANDONED

Contractor

E. H. 1847

NE NW

SECTION PLAT

330 Ft. from N. Line

_____ Ft. from S. Line

330 Ft. from E. Line

_____ Ft. from W. Line

Ellis County

Location _____

Rig up _____

Drilling and Remarks:

As 330

RECORD

Cased _____ in., _____ ft.

Sand _____

Gas _____

Oil _____

Total Depth 3412

PRODUCTION

1st 24 hrs. Nat. _____

1st 24 hrs. after shot _____

Gas _____ Cu. Ft.

Dry Hole _____

Abandoned _____


Date

OCT 29 1947

19

S. J. LEWIS

Scout

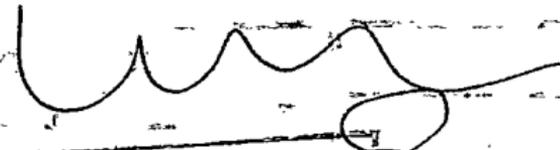

Small Maps

Clare

B

B

clock