


Ellis

KANSAS

SECTION 27 TOWNSHIP 14 RANGE 16W

WELL NO. #2 Schulte

COMPANY Fred J. Haynes

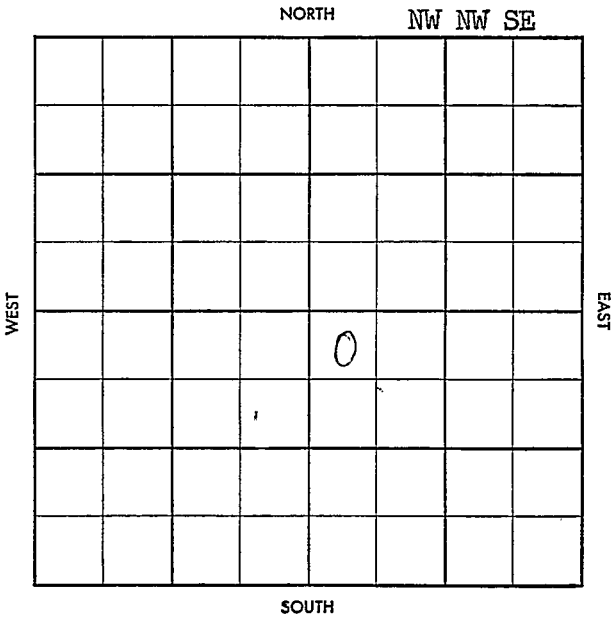

CO. Ellis ELEV 1842
SEC. 27 TWP. 14 RGE. 16W
COMPANY Fred J. Haynes NO. 2

COMPLETE
JAN 15 '58

FARM Schulte

LOC. NW NW SE

L 3091	
C 3342	
A 3350	
TD 3354	

GEOL. _____
CONTR. _____
POOL Dreiling SE
SPUD 10-4+57
Location 8 1/2" 945-11850
OCT 16 '57 5 1/2 3353
NOV 23 '57 ~~60-3354~~
DST 3093-3140
60" 240' M FPO-210

BHP 585/30" DST 3153-95 60" 400'
SW KP 100-240 BHP 495/30"
DST 3270-91 30" 4' M FPO-OBHP
0/15" 3 1/2" 3353 CO 3354
250A POP lots water

NOV 27 '57

JAN 2 '58 JAN 8 '53 → JAN 15 '58 DEC 26 '57
P 1830

+ 35BW pd
air 3353-54

CO.
LSE.
NO.
SEC.
TWP.
RGE.