


Ellis

KANSAS

SECTION 27 TOWNSHIP 14 RANGE 16W

WELL NO. #3 Schrant

COMPANY Keystone Petr. Inc.

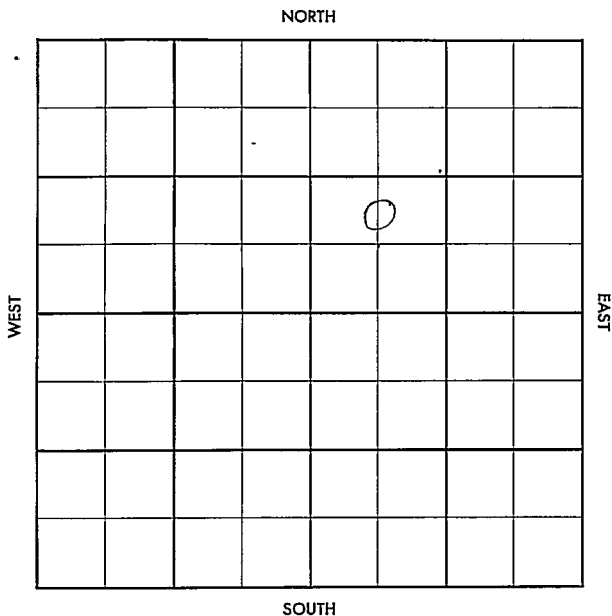

County Ellis Elev. 1859
 Sec. 27 Twp. 14 Rge. 16W
 Company Keystone Pet. Inc.
 Farm Name Schrant No. 3

TOPS	DEPTH	LOG	DATUM	Loc. in Sec.
Anh.	944			C N/2 SW NE
Tr.				500 fwl
H.				
Tr.				
Dg.				
BL.				
L.				Geol.
K.C.				Contr.
B.K.C.				Mast Drlg. Tools
Ce.				Pool
C.				
M.				
M.				
K.				
Mz.				Dreiling
Mo.				
V.				
S.				
S.				
A.				
R.				
Pe.				
G.				
T.D.				

OUT 17 56

FIRST REPORT

Date Comm. spd 10-9-56

8" @ 955 w/1.30, Drlg. 2965

63PI DC 100

Co.

1st

No.


Sec.

T.

R.

County Ellis Elev. 1859
 Sec. 27 Twp. 14 Rge. 16W
 Company Keystone Pet. Inc.
 Farm Name Schrant No. 3

TOPS	DEPTH	LOG	DATUM	Loc. in Sec.
Anh.	944			C N/2 SW NE
Tr.				
H.	3062			500 fwl
Tr.	3087			
Dg.				
Bl.				
L.	3110			Geol.
K.C.				Contr.
B.K.C.				Mast Drlg. Tools
Ce.				
C.	3353			Pool
M.				Dreiling
M.				
K.				
Mz.				
Mo.				
V.				
S.				
S.				
A.	3356			
R.				
PE.				
G.				
TD.	3400			

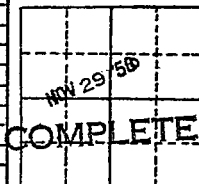

Date Comm. spd 10-9-56

8" @ 955 w/L30, Drlg. 2965 DC 24 56

5 1/2 @ 3399 / 100 CO 3391

36 / 3367-76 FU 1/2 Bo 8 hrs

NOV 31 56 1 1/2 Boph no/w

3 hrs 1 1/2 \$ 30 Bo 8 hrs

no/wt POF NOV 7 56 NOV 13 56 NOV 21 56

NOV 28 56 P. 25 Bopd no/wt