


Section 27 Township 14 Range 14-W

Well No. 1 Olson "C"

Company Stearns & Vernon

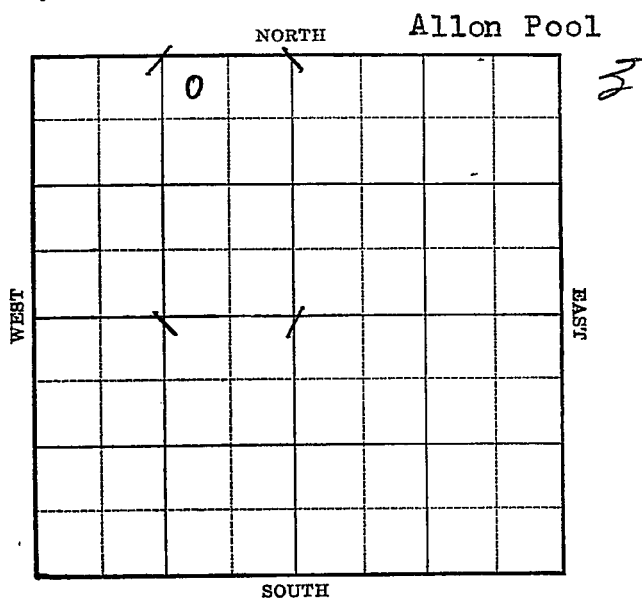

KANSAS

Russell

Sec. 27 Twp. 14 R. 14-WWell No. #1 Olson "C" FarmStearns & Vernon Company

(Allon)


330 Ft. from N. Line

Ft. from S. Line

990 Ft. from E. Line

Ft. from W. Line

Elev. 1841

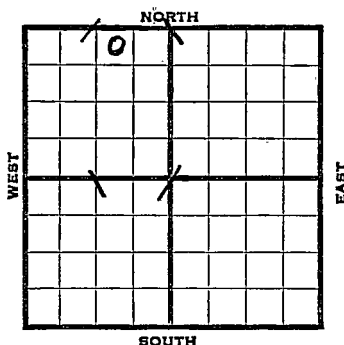

1939	REPORT
4/12	Cellar.
4/21	B. C. R.
4/28	C.R.
5/3	"
5/12	Drig. 315'
5/19	15" - 376' 13-3/8" - 513'
	Anhy 815' 8 1/4" - 820'
	Drig. 839'
5/26	Drig. 1926'
6/1	8" - 2090' T.D. 2223'
	U. R. '8".
6/8	8" @ 2216'
	Drig. 2313'
6/16	8" - 2317' Gas 2365'
	Drig. 2433'
6/23	7" - 2549' Drig. 2675'
6/29	S.O. 2697-2700' S.O. 2765-70'
	Dodge 2940' TD 2955' U.R. 5".
7/6	Lans. 2982' 6" - 2985'
	T.D. 2987' Drig. cement.
	OVER.

1939

7/12

Lans. 2982'

6" - 2985'

T.D. 2993'

Potential 3192 bbls., pump.

COMPLETED


Map No. 72 Sec. 27 Twp. 14 R. 14WWell No. 1 Olson "C"Stearns & Vernon

Company

Contractor

FIRST REPORT*Ohio F.O.***SECTION PLAT**

NW NE NW

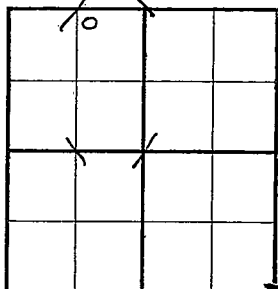330 Ft. from N. Line Ft. from S. Line990 Ft. from E. Line Ft. from W. Line

ALLON POOL

Location Rig up

Drilling and Remarks:

Cellar

RECORDCased in., ft.Sand Gas Oil Total Depth **PRODUCTION**1st 24 hrs. Nat. 1st 24 hrs. after shot Gas Cu. Ft.Dry Hole Abandoned

Date

APR 12 1939 19 H. D. Hatfield Scout

Misc. Small Maps	<i>Paul</i>
Cards	<i>Paul</i>
Tracing	<i>Jim</i>
France Map	<i>Paul</i>
Scarborough Map	<i>Paul</i>
Moody Map	<i>Paul</i>
Geological Dept.	<i>✓</i>
Moody Flat Book	

Map No. _____ Sec. 27 Twp. 14S R. 14WWell No. 1 Olson "C"Stearns & Vernon

Company

Contractor

COMPLETED


NW NE NW

330 Ft. from N. Line

_____ Ft. from S. Line

990 Ft. from E. Line

_____ Ft. from W. Line

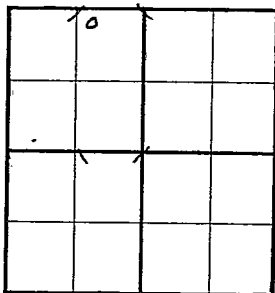SECTION PLAT**ALLON POOL**

Location _____

Rig up _____

Drilling and Remarks:

*Loc 2982**6 "C 2985**Pump P-83192***RECORD**

Cased _____ in., _____ ft.

Sand _____

Gas _____

Oil _____

Total Depth 2998**PRODUCTION**

1st 24 hrs. Nat. _____

1st 24 hrs. after shot _____

Gas _____ Cu. Ft.

Dry Hole _____

Abandoned _____

Date

Jul 12 '9 19S. J. LEWIS

Scout

Misc Small Maps
Cards
Tracing
France Map
Scarborough Map
Moody Map
Geological Dept.
Moody Plat Book