


Section 27 Township 14 Range 14-W

Well No. #4 Olson "C"

Company Stearns & Vernon

Gurney Pool

NORTH

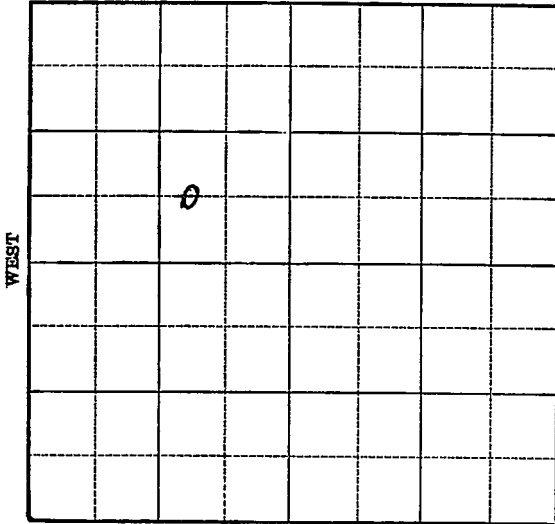

SOUTH

Sec. 27 Twp. 14 R. 14-W

Well No. #4 Olson "C" Farm

Stearns & Vernon Company


(Gurney)

\_\_\_\_\_ Ft. from N. Line

660 Ft. from S. Line

990 Ft. from E. Line

\_\_\_\_\_ Ft. from W. Line

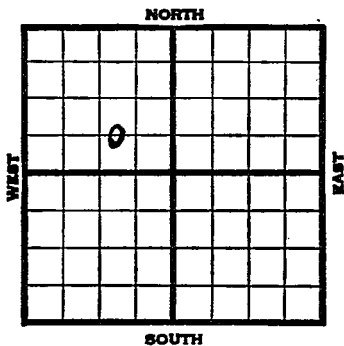

Elev. 1821

1940	REPORT
2/21	R.O.G.
2/29	Rigging up cable.
3/8	Spudding.
3/14	13" - 480' Anhy 794'
	10" - 798' Drlg. 810'
3/21	Ft. Riley 1705' Drlg. 2145'
3/28	S. Gas 2342-45' 8" - 2467'
	Drlg. 2675'
4/4	Topeka 2651' Lans. 2933-35' TD
	7" - 2935'
4/10	Lansing 2933'
	T.D. 2994'
	8000 acid.
	Pump & flow 3836 bbls., Potentia
	<b>COMPLETED</b>

Map No. 72 Sec. 27 Twp. 14 R. 14WWell No. 4 Olson "C"Stearns & Vernon Company

Contractor

FIRST REPORT  
C W L SE NW

## SECTION PLAT

         Ft. from N. Line660 Ft. from S. Line990 Ft. from E. Line         Ft. from W. Line

GURNEY POOL

	o		

Location                                 Rig up                                 Drilling and Remarks:  
ROG

## RECORD

Cased          in.,          ft.Sand                                 Gas                                 Oil                                 Total Depth:                         

## PRODUCTION

1st 24 hrs. Nat.                         1st 24 hrs. after shot                         Gas                                  Cu. Ft.:Dry Hole                                 Abandoned                                 

Date

FEB 21 1940<sub>19</sub>S. J. LEWIS Scout

Map No. 72 Sec. 27 Twp. 14 R. 14W

Well No. 4 Olson "C"

Stearns & Vernon Company

Contractor

**COMPLETED**

C W L SE NW

\_\_\_\_\_ Ft. from N. Line

660 Ft. from S. Line

990 Ft. from E. Line

\_\_\_\_\_ Ft. from W. Line

**SECTION PLAT**

	o		

**GURNEY POOL**

Location \_\_\_\_\_

Rig up \_\_\_\_\_

Drilling and Remarks:

*8000 acid*

*pump + flow  
Pot. 3836 bbls.*

**RECORD**

Cased \_\_\_\_\_ in., \_\_\_\_\_ ft.

Sand *Lansing 2933*

Gas \_\_\_\_\_

Oil \_\_\_\_\_

Total Depth *2994*

**PRODUCTION**

1st 24 hrs. Nat. \_\_\_\_\_

1st 24 hrs. after shot \_\_\_\_\_

Gas \_\_\_\_\_ Cu. Ft.

Dry Hole \_\_\_\_\_

Abandoned \_\_\_\_\_

Date

**APR 10 1940**

19

**S. J. LEWIS** Scout