

KANSAS

Gurney


Form 51-5M-7-39-Palace

Section 27 Township 14 Range 14-W

Well No. #5 F. Krug "B"

Company Stanolind

NORTH Gurney Pool

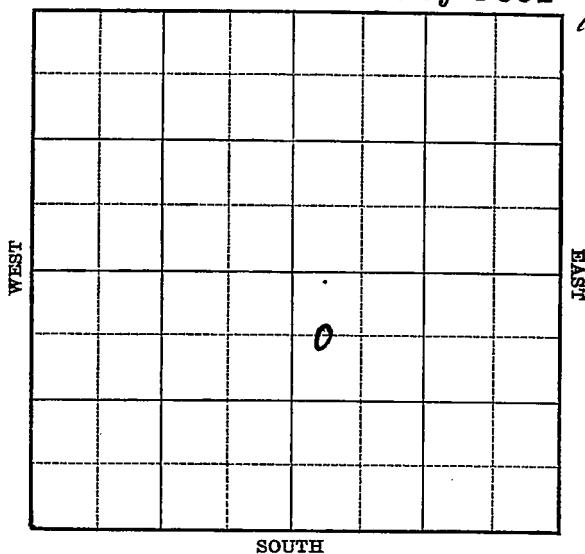

KANSAS

Russell


Sec. 27 Twp. 14 R. 14-WWell No. #5 F. Krug "B" FarmStanolind

Company

(Gurney)

660 Ft. from N. Line Ft. from S. Line Ft. from E. Line330 Ft. from W. Line

Elev. 1802

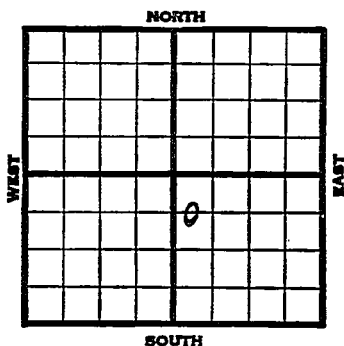

1940	REPORT
3/6	Location
3/14	"
3/21	"
3/28	20" - 39'
	Spud 290'
4/4	13" - 506' Drlg.
4/12	Anhv 775' 10" -- 780'
	Drlg. 1400'
4/18	8" - 2118' Drlg. 2135'
4/25	8" - 2160' 2400' U.R. 8".
5/2	8" - 2585' Drlg. 2790'
5/9	Lansing 2939' Oil 2964-66'
	7" - 2945' WOC.
5/15	Lans. 2939'
	7" - 2945'
	T.D. 3045'
	8000 acid.
	Potential, Pump 1630 oil & 288
	water.
	COMPLETED

Map No. 72 Sec. 27 Twp. 14 R. 14WWell No. 5 F. Krug "B"

Stanolind


Company

Contractor

FIRST REPORT

C $W\frac{1}{2}$ NW SE

SECTION PLAT

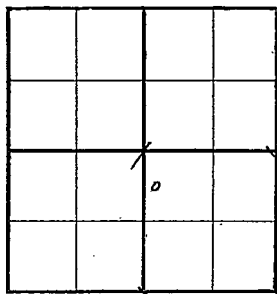660 Ft. from N. Line

_____ Ft. from S. Line

_____ Ft. from E. Line

330 Ft. from W. Line

GURNEY POOL

Location X

Rig up _____

Drilling and Remarks:

RECORD

Cased _____ in., _____ ft.

Sand _____

Gas _____

Oil _____

Total Depth _____

PRODUCTION

1st 24 hrs. Nat. _____

1st 24 hrs. after shot _____

Gas _____ Cu. Ft.

Dry Hole _____

Abandoned _____

Date

MAR 6 1940 19

S. J. LEWIS Scout

