

# KANSAS


Russell

Form 51-5M-11-38-Palace

Section 27 Township 14 Range 14-W

Well No. #3 Krug "A"

Company Stanolind

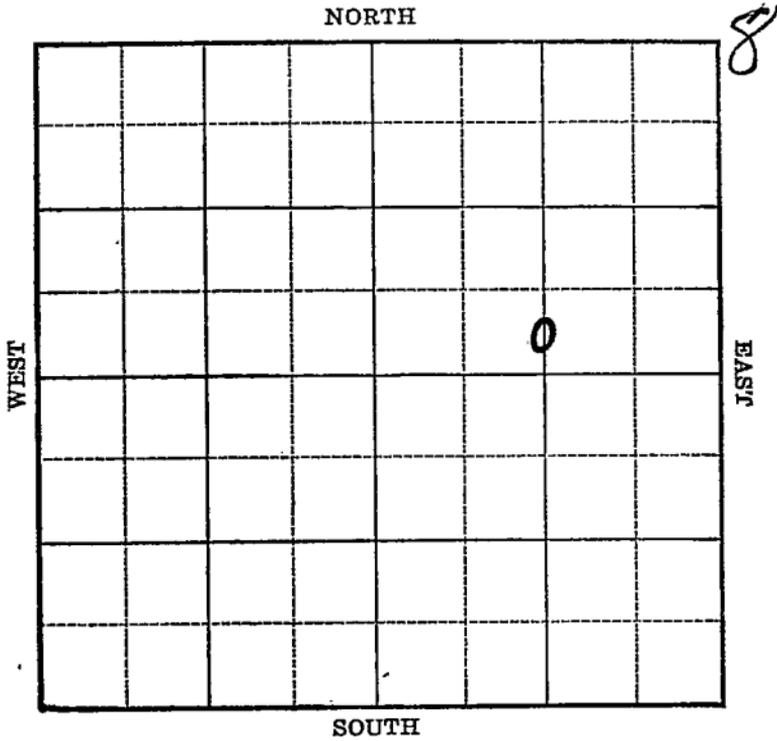

Sec. 27 Twp. 14 R. 14-WWell No. #3 Krug "A" FarmStanolini Company


(Alton)

\_\_\_\_\_ Ft. from N. Line

330 Ft. from S. Line1320 Ft. from E. Line

\_\_\_\_\_ Ft. from W. Line

Elev. 1807

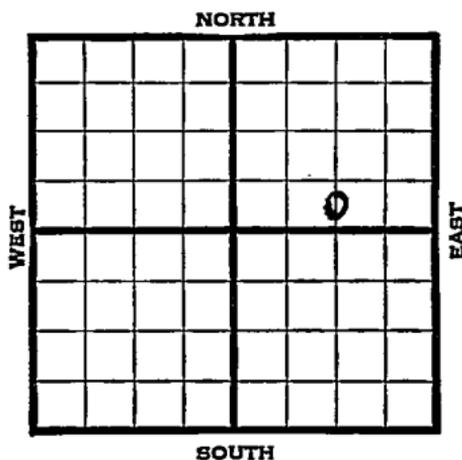

1939

REPORT

7/19

Location

7/27

Machine.

Rigging up.

8/3

20" - 38' Drlg. 450'

8/10

Anhy 780' 10" - 785'

Drlg. 885'

8/17

Drlg. 2015'

8/24

8" - 2392' Drlg. 2525'

9/7

7" - 2945' T.D. 2997'

P. B. 2976' Drlg. cement.

9/13

Lans. 2947'

7" - 2945'

T.D. 2997'

8000 acid.

Potential 1513 bbls., pump.

COMPLETED

Russell KANSAS

Map No. 72 Sec. 27 Twp. 14 R. 14WWell No. 3 Krug "A"

Stanolind

Company

Contractor

## FIRST REPORT

C S L N E

## SECTION PLAT


\_\_\_\_\_ Ft. from N. Line

330 Ft. from S. Line1320 Ft. from E. Line

\_\_\_\_\_ Ft. from W. Line

ALLON POOL

Location X

Rig up \_\_\_\_\_

Drilling and Remarks:

## RECORD

Cased \_\_\_\_\_ in., \_\_\_\_\_ ft.

Sand \_\_\_\_\_

Gas \_\_\_\_\_

Oil \_\_\_\_\_

Total Depth \_\_\_\_\_

## PRODUCTION

1st 24 hrs. Nat. \_\_\_\_\_

1st 24 hrs. after shot \_\_\_\_\_

Gas \_\_\_\_\_ Cu. Ft.

Dry Hole \_\_\_\_\_

Abandoned \_\_\_\_\_

Date

UL 19 1939

19

S. J. LEWIS

Scout

Map No. \_\_\_\_\_ Sec. 27 Twp. 14 R. 14W

Well No. 3 Krug "A"

Stanolind Company

Contractor

**COMPLETED**

**C S L N E**

\_\_\_\_\_ Ft. from N. Line

330 Ft. from S. Line

1320 Ft. from E. Line

\_\_\_\_\_ Ft. from W. Line

**SECTION PLAT**


**ALLON POOL**

Location \_\_\_\_\_

Rig up \_\_\_\_\_

Drilling and Remarks:

*Lane 2947*

*7" C 2945*

*8000 acid*

*Pump 1513 Pt.*

**RECORD**

Cased \_\_\_\_\_ in., \_\_\_\_\_ ft.

Sand \_\_\_\_\_

Gas \_\_\_\_\_

Oil \_\_\_\_\_

Total Depth 2987

**PRODUCTION**

1st 24 hrs. Nat. \_\_\_\_\_

1st 24 hrs. after shot \_\_\_\_\_

Gas \_\_\_\_\_ Cu. Ft.

Dry Hole \_\_\_\_\_

Abandoned \_\_\_\_\_

Date

SEP 13 1939 19

S. J. LEWIS Scout