

KANSAS

Form 51—5M—11-38—Palace


Russell

Section 27 Township 14 Range 14-W

Well No. #5 Krug "A"

Company Stanolind

NORTH Allon Pool

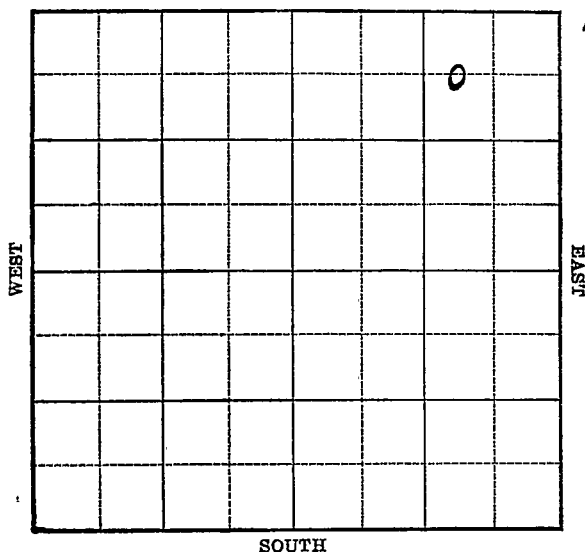

KANSAS


Russell

Sec. 27 Twp. 14 R. 14-WWell No. #5 Krug "A" FarmStanolind Company

(Allon)

660 Ft. from N. Line Ft. from S. Line990 Ft. from E. Line Ft. from W. Line

Elev. 1828

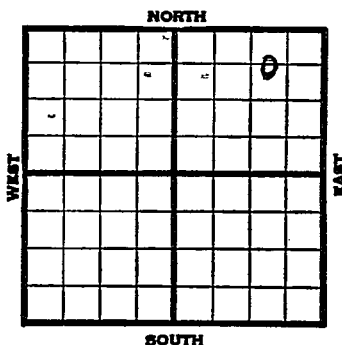

1939	REPORT
9/20	Location
9/28	Rigging up machine.
10/5	13" - 491' WOC.
10/12	Anhy 810' 10" - 815'
	Drlg. 1405'
10/19	Drlg. 2335'
10/26	S.G. 2355' S.G. 2430-35'
	8" - 2411' S.G. 2687'
	Drlg. 2760'
11/2	8" - 2677' Drlg. 2880'
11/9	Lans. 2977' 7" - 2982'
	Oil 3000-06' T.D. 3012'
	175' oil. WOC.
11/16	Coring 3065' Swab 206 bbls. oil

OVER

1939

11/22 Lans. 2977'
7" - 2982'
T.D. 3078'
P. B. to 3075'
8000 acid.
Pump 1400 oil, 1~~4~~ water.

COMPLETED

Map No. _____ Sec. 27 Twp. 14 R. 14WWell No. 5 Krug "A"Stanolind

Company

Contractor

BEST REPORT

C $W\frac{1}{2}$ NE NE660 Ft. from N. Line

_____ Ft. from S. Line

990 Ft. from E. Line

_____ Ft. from W. Line

SECTION PLAT

			0

ALLON POOL

Location X

Rig up _____

Drilling and Remarks:

RECORD

Cased _____ in., _____ ft.

Sand _____

Gas _____

Oil _____

Total Depth _____

PRODUCTION

1st 24 hrs. Nat. _____

1st 24 hrs. after shot _____

Gas _____ Cu. Ft.

Dry Hole _____

Abandoned _____

Date

SEP 20 1939

S. L. LEWIS

Scout

~~Misc Small Misc~~

Cards

TRACTS

RAY
RAY
RAY

Map No. 72 Sec. 27 Twp. 14 R. 14W
 Well No. 5 Krug "A"

Stanolind

Company

Contractor

COMPLETED

C $W\frac{1}{2}$ NE NE660 Ft. from N. Line

Ft. from S. Line

990 Ft. from E. Line

Ft. from W. Line

SECTION PLAT

			D

ALLON POOL

Location

Rig up

Drilling and Remarks:

*have 2977**7" C 2982**P.B 3075**10000 and**Pump 1400 oil 1900**P.O.X.*

RECORD

Cased _____ in., _____ ft.

Sand _____

Gas _____

Oil _____

Total Depth 3078

PRODUCTION

1st 24 hrs: Nat. _____

1st 24 hrs. after shot _____

Gas _____ Cu. Ft.

Dry Hole _____

Abandoned _____

Date

NOV 22 1939

S. I. LEWIS Scout

Misc Small Maps

Cards

Tracing

France Map

Scarborough Map

Moody Map

Geological Dept.

Moody Flat Book