

Sec. 27 Twp. 14 R. 14-WWell No. #6 Krug "A" FarmStanolind Company

(Allon)


330 Ft. from N. Line

_____ Ft. from S. Line

330 Ft. from E. Line

_____ Ft. from W. Line

Elev. 1811

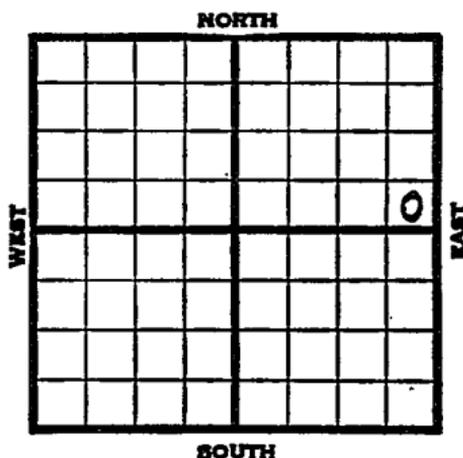

1939	REPORT
9/20	Location
9/28	Building cable rig.
10/5	Spud. 38' of 20".
10/12	15 $\frac{1}{2}$ " - 346' 13" - 487' T.D. 495' WOC.
10/19	Anhy 790' Drlg. 1455'
10/26	10" - 794' Drlg. 2305'
11/2	Topeka 2653' Lans. 2945' 7" - 2950' S.O. 2969-73' Coring 2977'
11/9	7" - 2968' WOC. T.D. 2994' 500' oil.
11/16	Coring 3043' 2000' oil.
11/22	Lans. 2994' 7" - 2968' T.D. 3051' 8000 acid. Potential 1654 bbls., pump.
	COMPLETED

Map No. _____ Sec. 27 Twp. 14 R. 14W

Well No. 6 Krug "A"

Stanolind Company

Contractor

FIRST REPORT

SE NE

330 Ft. from N. Line

_____ Ft. from S. Line

330 Ft. from E. Line

_____ Ft. from W. Line

SECTION PLAT

			0

ALLEN POOL

Location X

Rig up _____

Drilling and Remarks: _____

RECORD

Cased _____ in., _____ ft.

Sand _____

Gas _____

Oil _____

Total Depth _____

PRODUCTION

1st 24 hrs. Nat. _____

1st 24 hrs. after shot _____

Gas _____ Cu. Ft.

Dry Hole _____

Abandoned _____

Date

1939

19

Scout

Misc Small Maps *RAY*
Cards *RAY*
Jim
RAY

Map No. 72 Sec. 27 Twp. 14 R. 14WWell No. 6 Krug "A"

Stanolind

Company

Contractor

COMPLETED

SE NE

330 Ft. from N. Line

_____ Ft. from S. Line

330 Ft. from E. Line

_____ Ft. from W. Line

ALLON POOL

SECTION PLAT

			0

Location _____

Rig up _____

Drilling and Remarks:

*trans 2994**7" C 2968**9000 acid**Pump 1654 P.D.*

RECORD

Cased _____ in., _____ ft.

Sand _____

Gas _____

Oil _____

Total Depth 3051

PRODUCTION

1st 24 hrs. Nat. _____

1st 24 hrs. after shot 360

Gas _____ Cu. Ft.

Dry Hole _____

Abandoned _____

Date

NOV 22 1939 19

S. I. LEWIS

Scout

Misc. Small Maps.....
Cards.....
Tracing.....
France Map.....
Scarborough Map.....
Moody Map.....
Geological Dept.
Moody Flat Book

Handwritten signatures and initials in cursive script, including 'RMS', 'JMS', and 'RMS', are written over the printed text.