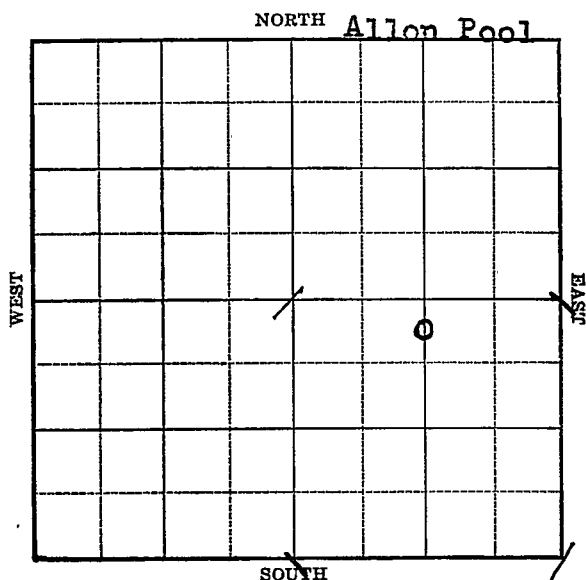


Russell KANSAS

Section 27 Township 14 Range 14-WWell No. 1 Krug "B"Company Stanolind

KANSAS


Russell

Sec. 27 Twp. 14 R. 14-WWell No. #1 Krug "B" FarmStanolind Company

(Allon)

330 Ft. from N. Line Ft. from S. Line1320 Ft. from E. Line Ft. from W. Line

Elev. 1801

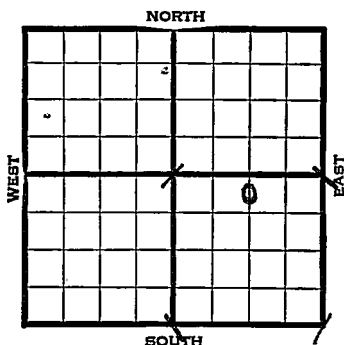

1939	REPORT
5/10	B.R.R.
5/19	Cable Rig.
5/26	16" - 32' Drlg. 219'
6/7	Drlg. 450' - - -
6/8	15" @ 349' Anhy 772'
	10-3/4" @ 771' Drlg. 1385'
6/16	8" - 2116' Drlg. 2220'
6/23	S. G. 2325' S. O. 2375'
	Topeka 2645' 7" - 2660'
	Drlg. 2670'
6/29	Lans. 2936' 7" - 2938'
	Pay 2972-78, T.D. 2980'
	1600' oil 10 hrs.
7/6	Swab 2 1/2 bbls. oil per hour 16 hours. Run tubing.
	OVER

1939

7/12

Lans. 2936'

7" - 2938'

T.D. 2980'

8000 acid.

Potential 2231 bbls., pump.

COMPLETED

Russell

KANSAS

Map No. _____ Sec. 27 Twp. 14 R. 14WWell No. 1 Krug "B"Stanolind


Company

Contractor

FIRST REPORT

C N L SE

SECTION PLAT

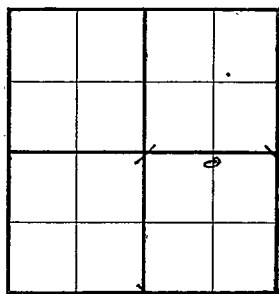330 Ft. from N. Line

_____ Ft. from S. Line

1320 Ft. from E. Line

_____ Ft. from W. Line

ALLON POOL

Location _____

Rig up _____

Drilling and Remarks:

BRR

RECORD

Cased _____ in., _____ ft.

Sand _____

Gas _____

Oil _____

Total Depth _____

PRODUCTION

1st 24 hrs. Nat. _____

1st 24 hrs. after shot _____

Gas _____ Cu. Ft.

Dry Hole _____

Abandoned _____

Date

MAY 10 1939

19

S. J. LEWIS

Scout

Misc. Small Maps

Cards

Tracing

France Map

Scarborough Map

Moody Map

Geological Dept.

Moody Flat Book

Map No. _____ Sec. 27 Twp. 14 R. 14WWell No. 1 Krug "B"

Stanolind

Company

Contractor

COMPLETED


SECTION PLAT

330 C N L SE
Ft. from N. Line

____ Ft. from S. Line

1320 Ft. from E. Line

____ Ft. from W. Line

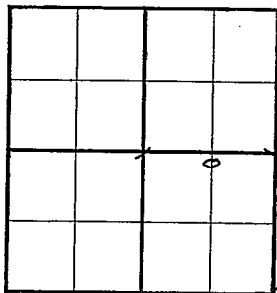

ALLON POOL

Location _____

RECORD

Cased _____ in., _____ ft.

Sand _____

Gas _____

Oil _____

Total Depth 2980

PRODUCTION

1st 24 hrs. Nat. _____

1st 24 hrs. after shot _____

Gas _____ Cu. Ft.

Dry Hole _____

Abandoned _____

Drilling and Remarks:

*Loss 2936.**7" @ 2938**8000 acid**Pump. P 28 2231*

Date

JUL 12 193919S. J. LEWISScout

Misc. Small Maps

Cards

Tracing

France Map

Scarborough Map

Moody Map

Geological Dept.

Moody Plat Book