

KANSAS

Russell

Section 27 Township 14 Range 14W

Well No. #5 Olson


Company Stearns Drlg.

Hall-Gurney Pool

NORTH

WEST

EAST

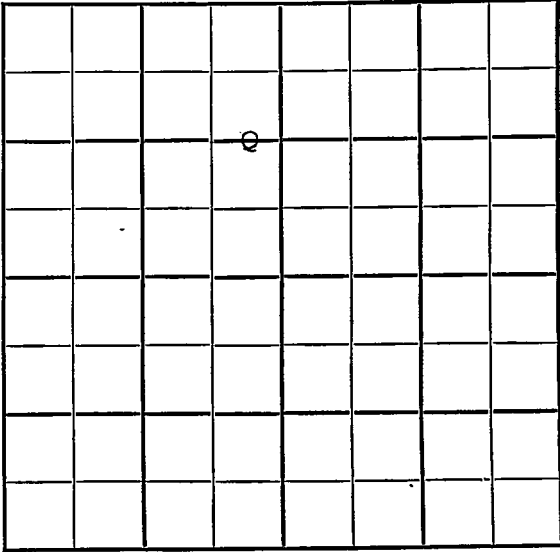

SOUTH

Sec. 27 Twp. 14 R. 14WWell No. #5 Olson Farm

Stearns Drlg.

Company

Hall-Gurney


1320 Ft. from N. Line

Ft. from S. Line

330 Ft. from E. Line

Ft. from W. Line

C E L NW

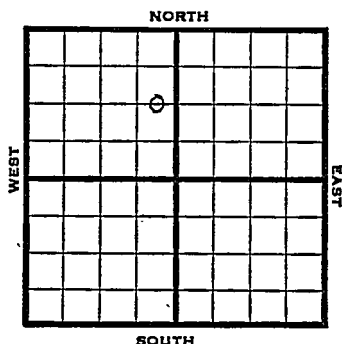

1948

Elev. 1838' REPORT

4/14

RUR

4/21

10" @ 305'
Drlg. 2102'

4/28

Lansing 2961'
7" @ 2961'
RUST

5/5

"

5/12

"

5/19

TD 3058'
500 acid
PB 3305'
2 B oil PH

5/26

Lans. 2961'
7" @ 2964'
5000 Acid
Pump 50 oil Pot.
Gr. 40.90
TD 3058'

COMPLETED

Map No. _____ Sec. 27 Twp. 14 R. 14W

Well No. 5 Olson

Stearns Drlg. Company

FIRST REPORT

Contractor

C E L NW


SECTION PLAT

1320 Ft. from N. Line

_____ Ft. from S. Line

330 Ft. from E. Line

_____ Ft. from W. Line

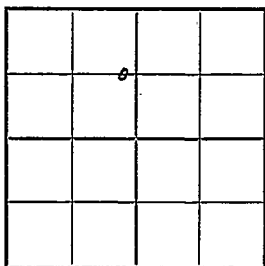

Russell County

Location _____

Rig up _____

Drilling and Remarks:

R U R

RECORD

Cased _____ in., _____ ft.

Sand _____

Gas _____

Oil _____

Total Depth _____

PRODUCTION

1st 24 hrs. Nat. _____

1st 24 hrs. after shot _____

Gas _____ Cu. Ft.

Dry Hole _____

Abandoned _____

Date

APR 14 1948 19 S. J. LEWIS Scout

Map No. 72 Sec. 27 Twp. 14 R. 14W

Well No. 5 Olson

Stearns Drlg.

Company

COMPLETE

Contractor

C E L NW

E. 1, 188
SECTION PLAT

1320 Ft. from N. Line

_____ Ft. from S. Line

330 Ft. from E. Line

_____ Ft. from W. Line

Russell County

Location _____

Rig up _____

Drilling and Remarks:

Law 2961

7" @ 2961

5000 acs - 6

Pump 50 oil Port

40 2 1/2

RECORD

Cased _____ in., _____ ft.

Sand _____

Gas _____

Oil ☒

Total Depth 3058

PRODUCTION

1st 24 hrs. Nat. _____

1st 24 hrs. after shot _____

Gas _____ Cu. Ft.

Dry Hole _____

Abandoned _____

Date

MAY 26 1948 19 S. J. LEWIS Scout