


Russell

KANSAS

SECTION 27 TOWNSHIP 14 RANGE 11 W

WELL NO. #10 F. Krug "A"

COMPANY Stanolind

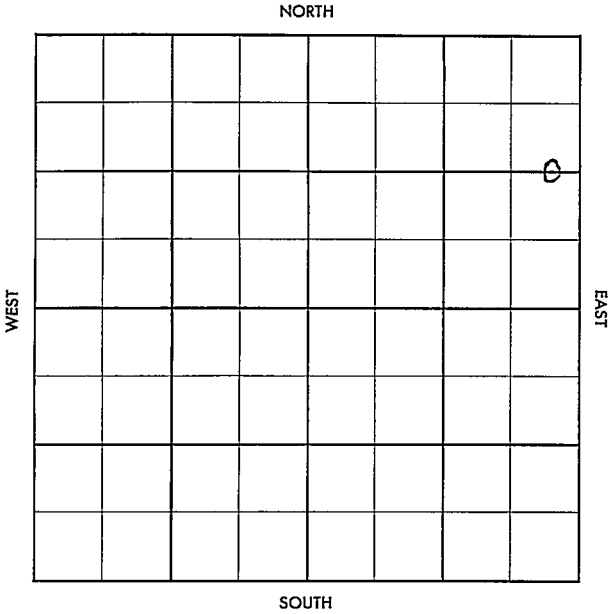

Russell

KANSAS

SEC. 27	TWP. 14	R. 14W
------------	------------	-----------

WELL NO.

#10-F. Krug "A"

FARM

COMPANY

Stanolind

CONTRACTOR

Prime Drlg.

Hall-Gurney


NORTH

\_\_\_\_\_ Ft. from N. Line

\_\_\_\_\_ Ft. from S. Line

\_\_\_\_\_ Ft. from E. Line

\_\_\_\_\_ Ft. from W. Line

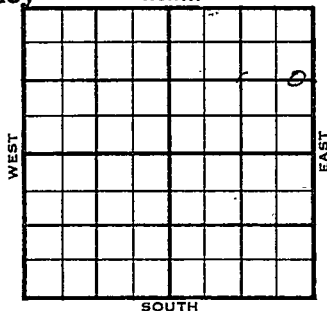C E $\frac{1}{2}$  E $\frac{1}{2}$  NE

1955

ELEVATION

1814

REPORT

11-23

Location

~~###~~

1956

1-5

Comm. 11-25-55

8 5/8" @ 811/400

5 1/2" @ 3113/150

CO to 3111 16/ 3105-09, 1000 A

SP 3100 16/ 3080-84, 1000 A

S/ 1 3/4 BO, 1 3/4 BWPH,

SP 3074, 32/ 3056-64, 1000 A,

S/ 5 bfph, 75% oil, 6 hrs.

S/ 5 boph,

CO to 3098

PB 3025, 12/ 2991-94, 16/ 2977-81,

12/ 2955-58

S/ 35 go, 33 gwph, 1000 A,

S/ 2 bfph, 25% wtr., 1000 A, Re-set pkr.

1000 A,

S/ 5 bfph, 25% wtr., 8 hrs., re-set pkr.

S/ 4.77 boph, 22% wtr., 6 hrs.,

CO to 3097

S/ 10 bfph, 35% wtr.,

Comp. 8 bopd

L. 2953

Anh. 799

796

H.  
Tr.2891  
2908

TD 3115'

COMPLETED

County Russell Elev. \_\_\_\_\_  
 Sec. 27 Twp. 11 Rgs. 11W  
 Company Stanolind  
 Farm Name F. Krug "A" No. 10

TOPS	DEPTH	LOG	DATUM	Loc. in Sec.
Anh.				C E $\frac{1}{2}$ E $\frac{1}{2}$ NE
Tr.				
H.				
Tr.				
Dg.				
Bl.				
L.				
K.C.				Geol. _____
B.K.C.				Contr. _____
Ce.				Prime Drlg
C.				
M.				Pool
M.				Hall-Jurney
K.				
Mz.				
Me.				
V.				
S.				
S.				
A.				
R.				
PE.				
G.				
T.D.				

NOV 23 '55  
 FIRST REPORT

Date Comm. \_\_\_\_\_  
 Location \_\_\_\_\_

\_\_\_\_\_  
 \_\_\_\_\_  
 \_\_\_\_\_  
 \_\_\_\_\_  
 \_\_\_\_\_  
 \_\_\_\_\_

~~10~~

Co.  
 No.  
 Sec.  
 T.  
 R.

County Russell Elev. 1814  
 Sec. 27 Twp. 11N Rge. 11W  
 Company Stanolind  
 Farm Name F. Krug "A" No. 10

TOPS	DEPTH	LOG	DATUM	Loc. in Sec.
Anh.	799	796		C E $\frac{1}{2}$ E $\frac{1}{2}$ NE
Tr.		2891	1077	
Dg.		2908	1094	
Bl.				
L.		2953	1139	
K.C.				Geol.
B.K.C.				Contr.
Ce.				Prime Drlg.
C.				
M.				Pool
M.				Hall-Gurney
K.				
Mz.				
Me.				
V.				
S.				
S.				
A.				
R.				
PE.				
G.				
TR.	3115			COMPLETE

Date Comm. 11-25-55 JAN 5 1956  
 8 5/8" @ 811/400 5 1/2" @ 3113/150  
 CO to 3111 16/ 3105-09 1000 A  
 SP 3100 16/ 3080-84 1000 A S/ 1 3/4  
 bo 1 3/4 bwph SP 3074 32/ 3056-64  
 1000 A S/ 5 bfph 75% oil 6 hr.  
 S/ 5 boph CO to 3098 PB 3025  
 12/ 2991-94 16/ 2977-81 12/ 2955-58  
 S/ 35 go 33 gwph 1000 A S/ 2 bfph

25% wtr. 1000 A reset packer 1000 A  
S/ 5 bfph 25% wtr. 8 hr. reset packer  
S/ 4.77 boph 22% wtr. 6 hr. CO to 3097  
S/ 10 bfph 35% wtr. Comp. 80 bopd

R. G.

JAN 12 1956