


Russell

KANSAS

Section 27 Township 14 Range 14-W

Well No. 1 Krug "A"


Company Stanolind

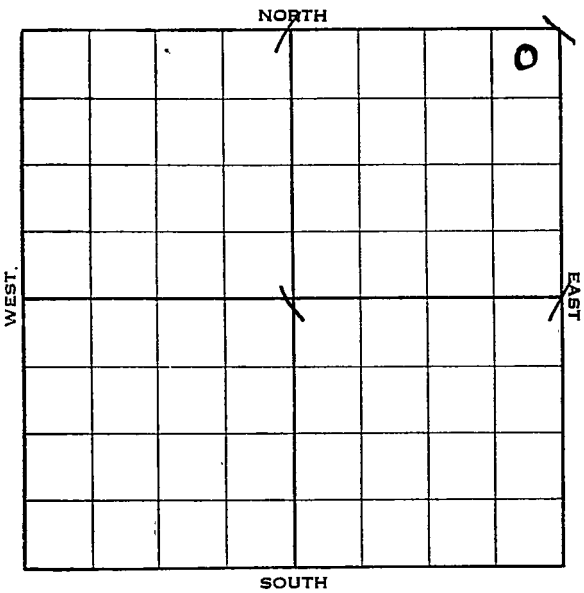

Sec. 27 Twp. 14 R. 14-W

Well No. #1 Krug "A" Farm _____
Stanolind Company

330 Ft. from N. Line
 _____ Ft. from S. Line
330 Ft. from E. Line
 _____ Ft. from W. Line
 Elev. 1820

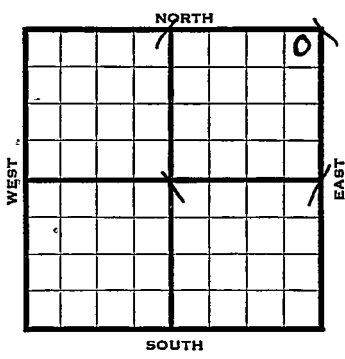

1938	REPORT
8/10	Location
8/19	Machine.
8/26	15" - 197'. WOC.
9/2	12" - 477'. Drlg. 770'.
9/9	Anh. 802'. 10" - 804'. Dlg. 1900'.
9/16	S. O. 2335-40'. 8" - 2405'. S. G. 2410-20'. Drlg. 2475'.
9/23	S. G. 2470-75'. S. O. 2595-2600'. T.D. 2680'. U. R. 8".
9/30	8" - 2669'. Dlg. 2695'.
10/7	Lans. 2959'. 7" - 2965'. Pay 2980-87'. T.D. 2988'. 1000' oil 15 hrs. WOC.
10/14	Swab 2½ oil per hour 13 hrs. Acidizing.
10/21	5000 acid. Flow 300 oil in 4 hrs
	OVER

1938

10/26 7" - 2965'.

Lans. 2959'.

T. D. 2988'.

5000 acid.

Potential 1109 bbls, Pump & flow.

COMPLETED

Russell KANSAS

Map No. 72 Sec. 27 Twp. 14 R. 14WWell No. 1-Krug "A"
Stanolind Company

Contractor

FIRST REPORT

NE/C

330 Ft. from N. Line Ft. from S. Line330 Ft. from E. Line Ft. from W. Line

SECTION PLAT

			○
		"A"	
		"B"	

Location XRig up

Drilling and Remarks:

RECORD

Cased in., ft.Sand Gas Oil Total Depth

PRODUCTION

1st 24 hrs. Nat. 1st 24 hrs. after shot Gas Cu. Ft.Dry Hole Abandoned

Date

AUG 10 1938

19

H. D. Hatfield

Scout

2
RAY

Returned _____
Cards _____ Paul
Tracing _____ Joe
Frence Map _____ RAY
Scarborough Map _____ RAY
Moody Map _____
Scarborough Plat Book _____
Moody Plat Book _____

Map No. 72 Sec. 27 Twp. 14 R. 14W

Well No. 1-Krug "A"

Stanolind

Company

Contractor

COMPLETED

NE/c

SECTION PLAT

330 Ft. from N. Line

_____ Ft. from S. Line

330 Ft. from E. Line

_____ Ft. from W. Line

			0

Location _____

Rig up _____

Drilling and Remarks:

5000 Acid.

POT 1109

Pump & Flow.

RECORD

Cased 7 in., 2965 ft.

Sand LENS 2959

Gas _____

Oil _____

Total Depth 2988

PRODUCTION

1st 24 hrs. Nat. _____

1st 24 hrs. after shot _____

Gas _____ Cu. Ft.

Dry Hole _____

Abandoned _____


Date

DEC 26 1938 19

1177

H. D. Hatfield

Scout

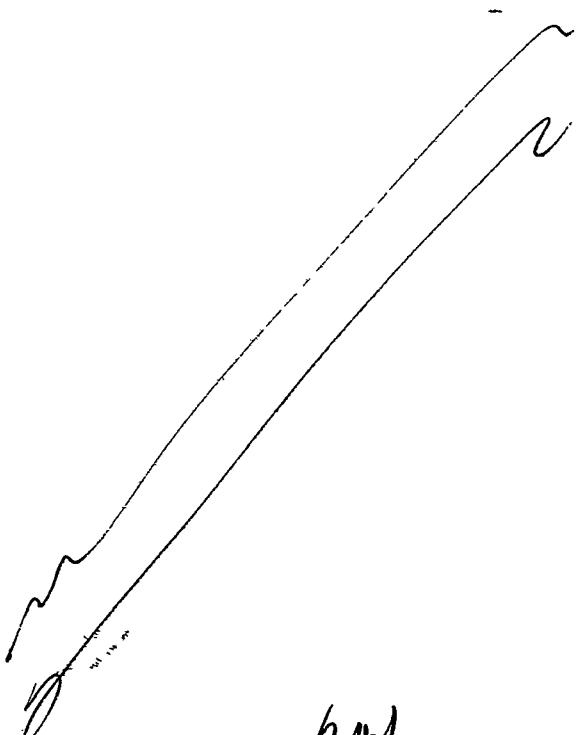

Misc Small	None
S	Paul
T	Joe
V	Ray
D	✓