

KANSAS

Form 51-5M-7-39-Palace


Russell

Section 27 Township 14 Range 14-W

Well No. #4 Krug "B"

Company Stanolind

NORTH Gurney Pool

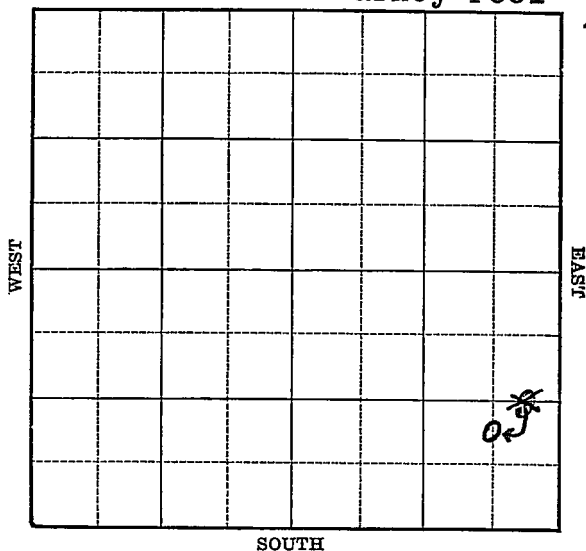

KANSAS

- Russell


Sec. 27 Twp. 14 R. 14-WWell No. #4 Krug "A" "B" FarmStanolind Company

(Gurney)

1320 Ft. from N. Line990 Ft. from S. Line660
330 Ft. from E. Line

Ft. from W. Line

Elev. 1788

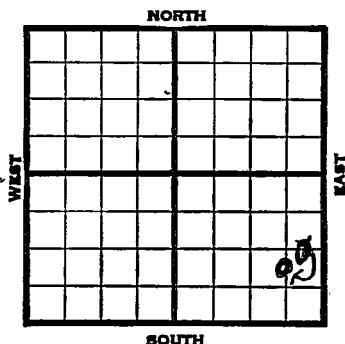

1939	REPORT
12/13	Location
12/21	"
12/28	"
1940	
1/4	"
1/11	R.O.G.
1/18	"
1/25	20" - 45' Drlg. 75'
2/1	13" - 525' WOC.
2/8	Anhv 755' 10" - 768'
	Drlg. 1315'
2/15	Drlg. 2270'
2/23	Topeka 2637' S.O. 2647'
	7" - 2846' Drlg. 2915'
2/29	T.D. 3180' Swab 1 bbl. oil per hour.
3/8	T.D. 3185' Swab 4 bbls. oil & 4 water per hour for 16 hours.
	OVER

1940
3/13

Lans. 2930'
7" - 2934'
Granite wash 3169'
Quartzite 3173'
T.D. 3185'

ABANDONED

Russell KANSAS

Map No. 72 Sec. 27 Twp. 14 R. 14WWell No. 4 Krug "B"

Stanolind

Company

Contractor

FIRST REPORT

C E L S E

1320 Ft. from N. Line

_____ Ft. from S. Line

330 Ft. from E. Line

_____ Ft. from W. Line

SECTION PLAT

GURNEY POOL

Location X

Rig up _____

Drilling and Remarks:

RECORD

Cased _____ in., _____ ft.

Sand _____

Gas _____

Oil _____

Total Depth _____

PRODUCTION

1st 24 hrs. Nat. _____

1st 24 hrs. after shot _____

Gas _____ Cu. Ft.

Dry Hole _____

Abandoned _____

Date

DEC 13 1939 19

S. J. LEWIS Scout

Misc. Small Maps

Cards

Tracing

France Map

Scarborough Map

Moody Map

Geological Dept.

Moody Flat Book

Russell KANSAS

Map No. 72 Sec. 27 Twp. 14 R. 14WWell No. 4 Krug "B"

Stanolind

Company

CORRECTION

Contractor

C N $\frac{1}{2}$ SE SE

SECTION PLAT

			o

 Ft. from N. Line990 Ft. from S. Line660 Ft. from E. Line Ft. from W. Line

GURNEY POOL

Location Rig up

Drilling and Remarks:

Reported
C E L SE

RECORD

Cased in., ft.Sand Gas Oil Total Depth

PRODUCTION

1st 24 hrs. Nat. 1st 24 hrs. after shot Gas Cu. Ft.Dry Hole Abandoned

Date

FEB 7 1940 19

S. J. LEWIS

Scout

Misc. Small Maps

Cards

Tracing

France Map

Scarborough Map

Moody Map

Geological Dept.

Moody Flat Book

Russell **KANSAS**Map No. 72 Sec. 27 Twp. 14 R. 14WWell No. 4 Krug "B"Stanolind Company

Contractor

ABANDONED

C N $\frac{1}{2}$ SE SE Ft. from N. Line990 Ft. from S. Line660 Ft. from E. Line Ft. from W. Line

SECTION PLAT

			0

GURNEY POOL

Location Rig up Drilling and Remarks: *Loss 2930**7" C 2934**Granite Wash 3169**Quartzite 3173*

RECORD

Cased in., ft.Sand Gas Oil Total Depth 3185

PRODUCTION

1st 24 hrs. Nat. 1st 24 hrs. after shot Gas Cu. Ft.Dry Hole Abandoned

Date

MAR 13 1940 19

S. J. LEWIS Scout

10-21-24

Misc Small Maps	RAM
Cards	RAM
Tracing	RAM
France Map	RAM
Scarborough Map	RAM
Moody Map	RAM
Geological Dept.	
Moody Flat Book	