

# KANSAS


FORM 51 5M 1-42 PETROL

Russell

Section 27 Township 14 Range 14-W

Well No. #6 - Krug "B"

Company Stanolind

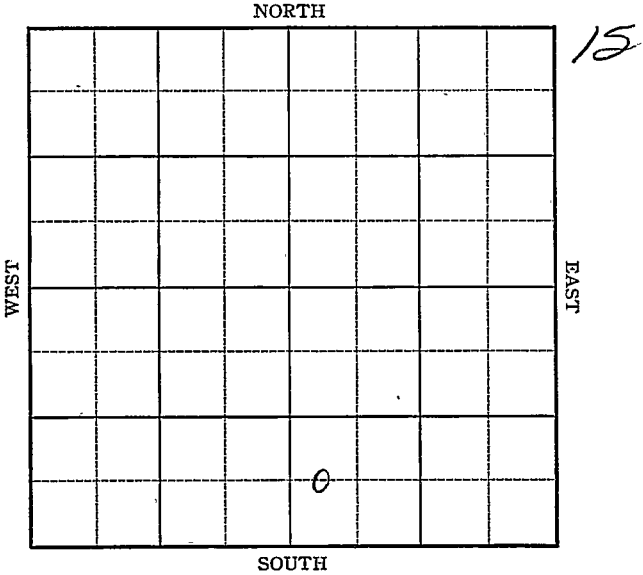

Sec. 27 Twp. 14 R. 14-W

Well No. #6 Krug "B" Farm

Stanolind Company

Hall-Gurnery


         Ft. from N. Line

660 Ft. from S. Line

         Ft. from E. Line

330 Ft. from W. Line

*Elev. 1801*

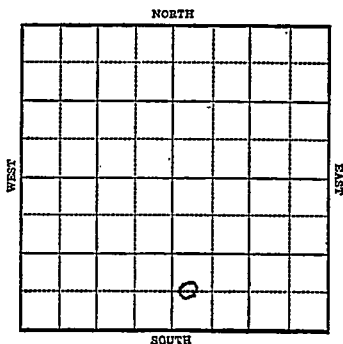

1943

R E P O R T

6/30

Location

7/7

Derrick

7/15

8" @ 520'

WOC.

7/21

Anhy 775

Drlg. 2610'

7/28

Topeka 2658

Lans 2944

orham 3172-78 T.D. SO

8/4

5" @ 3172'

Rust

8/11

T.D. 3210

No shows

PB

8/18

PB 3098

48 shots 3033-45,

84 shots 2964-84

5500 acid swab 200 oil in 20 hr

**OVER**

1943

8/25

Lans 2944

5" @ 3172

Sooy Sd 3172

PB 3098

Perf. Lans

5500 acid

Pump 344 Pot.

T.D. 3210

Gravity 38

||

**COMPLETED**

KANSAS

Rus sell

Map No. 72 Sec. 27 Twp. 14 R. 14WWell No. 6 Krug "B"Stanolind

Company

FIRST REPORT

Contractor

C WL SW SE

\_\_\_\_\_ Ft. from N. Line

660 Ft. from S. Line

\_\_\_\_\_ Ft. from E. Line

330 Ft. from W. Line

## SECTION PLAT


HALL-GURNEY POOLLocation XXX

Rig up \_\_\_\_\_

Drilling and Remarks: \_\_\_\_\_

## RECORD

Cased \_\_\_\_\_ in., \_\_\_\_\_ ft.

Sand \_\_\_\_\_

Gas \_\_\_\_\_

Oil \_\_\_\_\_

Total Depth \_\_\_\_\_

## PRODUCTION

1st 24 hrs. Nat. \_\_\_\_\_

1st 24 hrs. after shot \_\_\_\_\_

Gas \_\_\_\_\_ Cu. Ft.

Dry Hole \_\_\_\_\_

Abandoned \_\_\_\_\_

Date

JUN 3 0 1943

19

S. J. LEWIS Scout

Misc. Small Maps	<i>One</i>
Cards	<i>MB</i>
Tracing	<i>MB</i>
France Map	<i>MB</i>
Scarborough Map	<i>MB</i>
Moody Map	<i>MB</i>
Geological Dept.	
Moody Flat Book	

Russell

**KANSAS**  
 Map No. 72 Sec. 27 Twp. 14 R. 14W

Well No. 6 Krug "B"Stanolind

Company

COMPLETED

Contractor

C W L SW SE

SECTION PLAT

         Ft. from N. Line660 Ft. from S. Line         Ft. from E. Line330 Ft. from W. Line

Hall-Gurney Pool


Location         Rig up         

Drilling and Remarks:

Lease 29445<sup>th</sup> 8172Comp 8172PR 3098Prof Lease5500 acs LPump 344 PR380 ft

Date

## RECORD

Cased          in.,          ft.Sand         Gas         Oil         Total Depth 2210

## PRODUCTION

1st 24 hrs. Nat. 35511st 24 hrs. after shot         Gas          Cu. Ft.Dry Hole         Abandoned         AUG 25 1943 19S. J. LEWIS Scout



Misc. Small Maps	<i>Oma</i>
Cards	<i>Wedge</i>
Tracing	<i>NE L</i>
France Map	<i>W</i>
Scarborough Map	<i>W</i>
Moody Map	<i>W</i>
Geological Dept.	
Moody Plat Book	