


Russell
KANSAS

Section 27 Township 14 Range 14-W

Well No. 8 Olson "A"

Company Stearns & Vernon

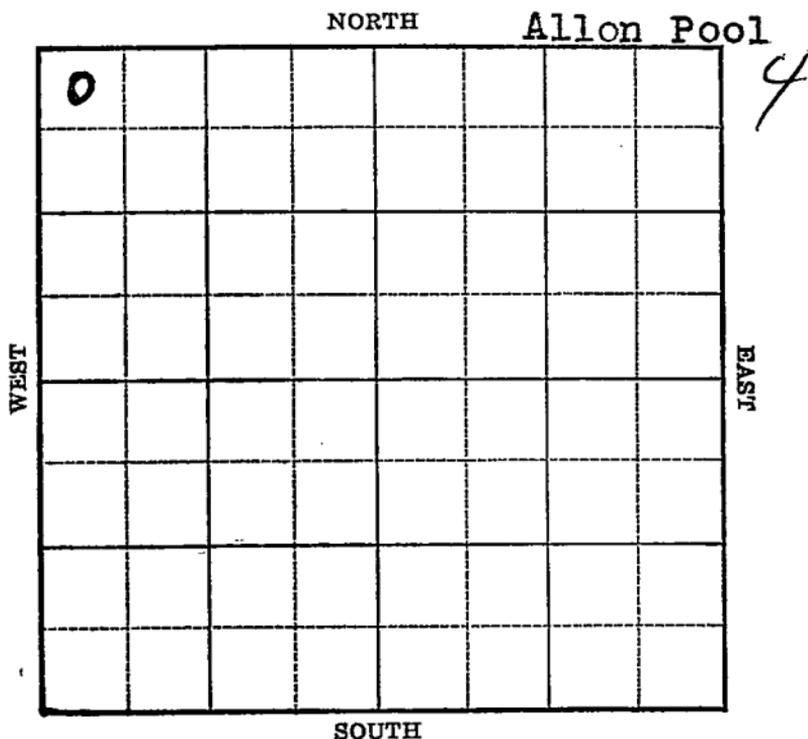

Sec. 27 Twp. 14 R. 14-W

Well No. #8 Olson "A" Farm

Stearns & Vernon Company

(Allon)


330 Ft. from N. Line

_____ Ft. from S. Line

_____ Ft. from E. Line

330 Ft. from W. Line

Elev. 1844

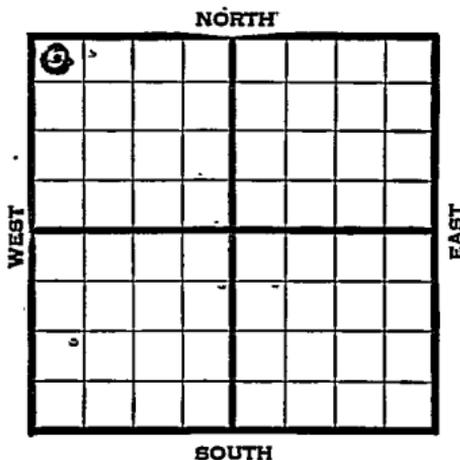

1939	REPORT
5/24	Cable Rig.
6/7	" "
6/8	" "
6/16	" "
6/23	" "
6/29	" "
7/6	" "
7/13	" "
7/20	Rigging up.
7/27	20" - 160' Drlg. 330'
8/3	15" - 361' 15" - 520'
	Anhy 819' 10" - 821'
	Drlg. 1200'
8/10	2131' run 8".
8/17	8" - 2164' Drlg. 2197'
8/24	8" - 2317' S.O. 2395-2400'
	Drlg. 2440'
8/31	8" - 2430' Drlg. 2675'
9/7	Dodge 2934' 7" - 2956'
	Drlg. 2966'
	OVER

1939

9/14 Lans. 2981' 7" - 2983'
T.D. 3085' Swab $3\frac{1}{2}$ bbls. oil
per hour.

9/20 Lans. 2981'
7" - 2983'
T.D. 3085'
8000 acid.
Pump 2711 bbls.

COMPLETED

Map No. 72 Sec. 27 Twp. 14 R. 14W

Well No. 8 Olson "A"

Stearns & Vernon

Company

Contractor

FIRST REPORT

SECTION PLAT

NW/C
330 Ft. from N. Line
 _____ Ft. from S. Line
 _____ Ft. from E. Line
330 Ft. from W. Line

o			

ALLEN POOL

Location X

Rig up _____

Drilling and Remarks: **Cable Rig**

RECORD

Cased _____ in., _____ ft.

Sand _____

Gas _____

Oil _____

Total Depth _____

PRODUCTION

1st 24 hrs. Nat. _____

1st 24 hrs. after shot _____

Gas _____ Cu. Ft.

Dry Hole _____

Abandoned _____

Date

MAY 24 1939 19

S. J. LEWIS Scout

Misc Small Maps	RAY
Cards	RAY
Tracing	RAY
France Map	RAY
Scarborough Map	RAY
Moody Map	RAY
Geological Dept.	RAY
Moody Plat Book	RAY

Map No. _____ Sec. 27 Twp. 14 R. 14WWell No. 8 Olson "A"Stearns & Vernon Company

Contractor

COMPLETED

NW/C

330 Ft. from N. Line

_____ Ft. from S. Line

_____ Ft. from E. Line

330 Ft. from W. Line**SECTION PLAT**

0			

ALLON POOL

Location _____

Rig up _____

Drilling and Remarks:

Law. 2981
7" @ 2983
7000 acid
Pump 2711

RECORD

Cased _____ in., _____ ft.

Sand _____

Gas _____

Oil _____

Total Depth 3085**PRODUCTION**

1st 24 hrs.. Nat. _____

1st 24 hrs. after shot _____

Gas _____ Cu. Ft.

Dry Hole _____

Abandoned _____

Date

SEP 20 1939 19

S. I. LEWIS Scout

of 0 1 2
1 2 3 4 5 6 7 8 9
10 11 12 13 14 15 16 17 18 19 20



Misc Small Maps	<i>[Signature]</i>
Cards	<i>[Signature]</i>
Tracing	<i>[Signature]</i>
From [unclear]	<i>[Signature]</i>
Map	<i>[Signature]</i>