

STATE CORPORATION COMMISSION OF KANSAS
OIL & GAS CONSERVATION DIVISION
WELL COMPLETION OR RECOMPLETION FORM
ACO-1 WELL HISTORY
DESCRIPTION OF WELL AND LEASE

Operator: License # 5181
Name Donald C. Slawson
Address 104 S. Broadway
200 Douglas Bldg.
City/State/Zip Wichita, KS 67202

Purchaser

Operator Contact Person William R. Horigan
Phone (316) 263-3201

Contractor: License # 5657
Name Slawson Drilling Company

Wellsite Geologist Bill Stout
Phone

Designate Type of Completion

New Well Re-Entry Workover
 Oil SWD Temp Abd
 Gas Inj Delayed Comp.
 Dry Other (Core, Water Supply etc.)

If ONWO: old well info as follows:

Operator
Well Name
Comp. Date Old Total Depth

WELL HISTORY

Drilling Method:

Mud Rotary Air Rotary Cable

11-23-87 12-3-87 12-3-87
Spud Date Date Reached TD Completion Date

4385'
Total Depth PBTD

Amount of Surface Pipe Set and Cemented at 322 feet
Multiple Stage Cementing Collar Used? Yes No

If yes, show depth set feet
If alternate 2 completion, cement circulated from feet depth to w/ SX cmt
Cement Company Name
Invoice #

API NO. 15-063-21,168

County Gove

NW SE NE Sec 13 Twp 14S Rge 28 East
X West

3630 Ft North from Southeast Corner of Section
990 Ft West from Southeast Corner of Section

(Note: Locate well in section plat below)


Lease Name Hefner "M" Well # 1

Field Name

Producing Formation

Elevation: Ground 2523' KB 2529'

Section Plat

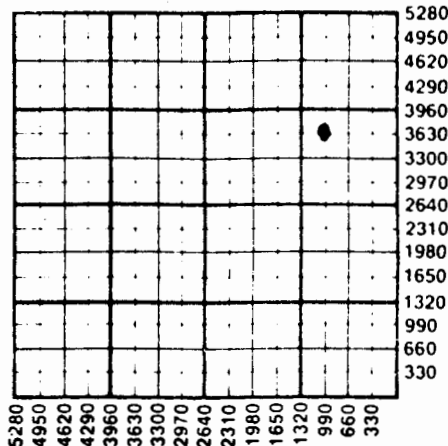

WATER SUPPLY INFORMATION

Disposition of Produced Water: Disposal
Docket # Repressuring

Questions on this portion of the ACO-1 call:

Water Resources Board (913) 296-3717

Source of Water:
Division of Water Resources Permit # N/A

Groundwater Ft North from Southeast Corner
(Well) Ft West from Southeast Corner of
Sec Twp Rge East West

Surface Water Ft North from Southeast Corner
(Stream, pond etc) Ft West from Southeast Corner
NE/4 Sec13 Twp 14S Rge 28 East X West

Other (explain)
(purchased from city, R.W.D. #)

INSTRUCTIONS: This form shall be completed in triplicate and filed with the Kansas Corporation Commission, 200 Colorado Derby Building, Wichita, Kansas 67202, within 120 days of the spud date of any well. Rule 82-3-130, 82-3-107 and 82-3-106 apply.

Information on side two of this form will be held confidential for a period of 12 months if requested in writing and submitted with the form. See rule 82-3-107 for confidentiality in excess of 12 months. One copy of all wireline logs and drillers time log shall be attached with this form. Submit CP-4 form with all plugged wells. Submit CP-111 form with all temporarily abandoned wells.