



Vintage Petroleum Inc.  
Kansas District

ORIGINAL

Date October 22, 2002

Well Name Coberly II 3  
Field Name Missouri Flats, N  
County Gove  
State Kansas

Legal Location C NW NE 21-14S-29W  
OTC No. \_\_\_\_\_  
API No. \_\_\_\_\_  
Property No. \_\_\_\_\_

KB: 2609'  
GL: 2605'

CASING			
Size	Description	Top	Bottom
8-5/8"	28#	Surf.	329'
4-1/2"	10.5#	Surf.	4348'

CEMENT	
Pipe Size	Description
8-5/8"	225 sx (CIRC)
4-1/2"	150 sx (TOC AT 3835')


TUBING STRING			
Description	Length	Depth	
2 3/8"		3912'	

RODS / PUMP			
Description	Length	Depth	

PUMPING UNIT	
Manufr:	
API Size:	
Crank Hole:	

PRIME MOVER	
TYPE	SIZE

FLUID PROPERTIES	
API Grav	Chlorides

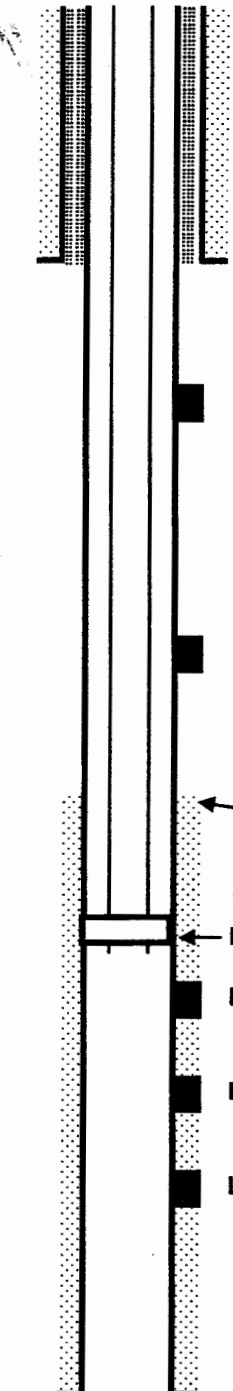

PUMPED 75 SX SMD W/ 3% CACL2  
DOWN 8 5/8" X 4 1/2" ANNULUS 9/20/02

PERF 650' FOR SQUEEZE 9/20/02  
SQZD W/ 100 SX SMD CMT

PERF 1100' FOR SQUEEZE 9/17/02  
SQZD W/ 200 SX SMD CMT W/ 3% CACL2

TOC @ 3835' (CBL - 9/17/02)

MODEL "R" DOUBLE GRIP PACKER @ 3912' +/-

LKC-160 (3952-62) - 9/02

LKC-180 (3977-83) - 9/75

LKC-200 (4012-20) - 9/02

PBTD 4335  
RTD 4342'

RECEIVED  
KANSAS CORPORATION COMMISSION

NOV 08 2002

CONSERVATION DIVISION  
WICHITA, KS