

KANSAS

Form 51-5M-7-40-Palace


Russell

Section 28 Township 14 Range 14-W

Well No. #2 Olson "B"


Company Stearns & Vernon

NORTH Gurney Pool

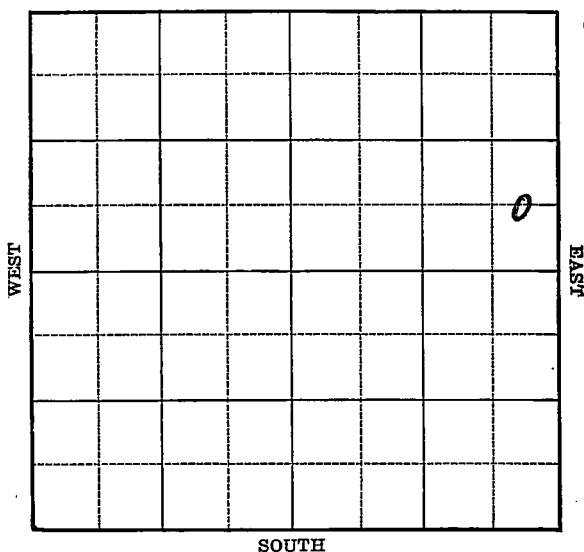

Company

Elev. 1804

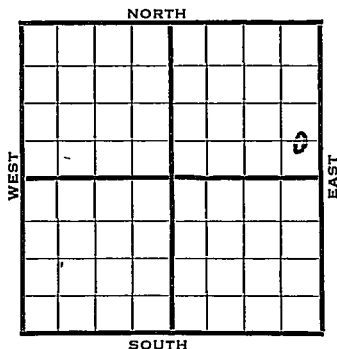

REPORT

ABANDONED

Map No. _____ Sec. 28 Twp. 14 R. 14WWell No. 2 Olson "B"Stearns & Vernon

Company

Contractor

C E L S E N E

_____ Ft. from N. Line

660 Ft. from S. Line330 Ft. from E. Line

_____ Ft. from W. Line

GURNEY POOL

SECTION PLAT

			0

Location _____

Rig up _____

Drilling and Remarks:

Cable

RECORD

Cased _____ in., _____ ft.

Sand _____

Gas _____

Oil _____

Total Depth _____

PRODUCTION

1st 24 hrs. Nat. _____

1st 24 hrs. after shot _____

Gas _____ Cu. Ft.

Dry Hole _____

Abandoned _____

Date

AUG 14 1940 19

S. J. LEWIS

Scout

Map No. 72 Sec. 28 Twp. 14 R. 14WWell No. 2 Olson "B"Stearns & Vernon Company

Contractor

ABANDONED

C E L S E N E

 Ft. from N. Line660 Ft. from S. Line330 Ft. from E. Line Ft. from W. Line

GURNEY POOL

SECTION PLAT

			o

Location Rig up

Drilling and Remarks:

*Granite Wash 8226**X F.V. 8281*

RECORD

Cased in., ft.Sand Gas Oil Total Depth 3285

PRODUCTION

1st 24 hrs. Nat. 1st 24 hrs. after shot Gas Cu. Ft.Dry Hole Abandoned

Date

OCT 16 1940 19

S. J. LEWIS Scout