

# KANSAS


FORM 51 5M PETROL

Russell

Section 28 Township 14 Range 14 W

Well No. #3 Olson "B"

Company Sterns, Vernon O&C etal

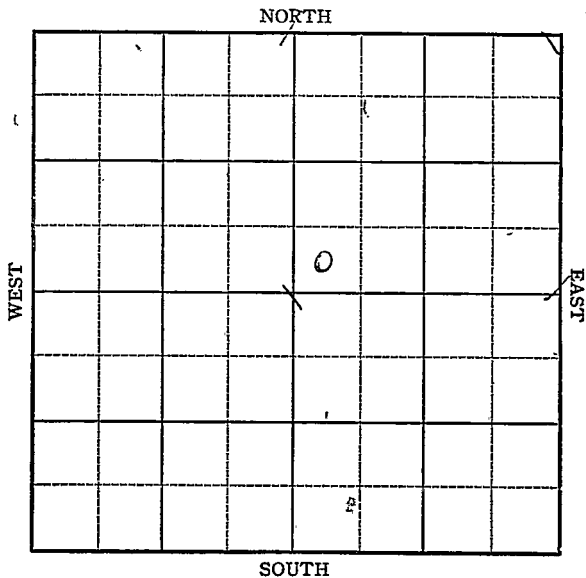

Sec. 28 Twp. 14 R. 14-W

Well No. #3 Olson "B" Farm

Sterns, Vernon O&G etal Company


\_\_\_\_\_ Ft. from N. Line

330 Ft. from S. Line

\_\_\_\_\_ Ft. from E. Line

330 Ft. from W. Line

Elev. 1813

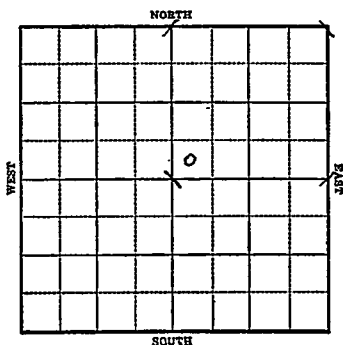

1943

R E P O R T

- 10/13 Cable rig and tools.
- 10/20 20" @ 55'  
15" @ 295'  
Drlg. 440
- 10/27 13" @ 510'  
Anhy 801  
10" @ 802'  
Drlg. 1635'
- 11/3 Drlg. 2310'
- 11/10 18" @ 2410' 70  
Drlg. 2675'
- 11/17 2690' fsg.
- 11/24 " "
- 12/1 6" @ 2725'  
Drlg 2925'
- 12/8 Topeka 2675  
Lans 2982  
7" @ 2981  
Drlg. 3175'
- 12/15 ARB 3278  
TD 3280

ABANDONED

Map No. KANSAS Sec. 28 Twp. 14 R. 14W

Well No. 3 Olson "B"

Sterns, Vernon O&G et. Company

FIRST REPORT

Contractor

SW NE


SECTION PLAT

\_\_\_\_\_ Ft. from N. Line

330 Ft. from S. Line

\_\_\_\_\_ Ft. from E. Line

330 Ft. from W. Line

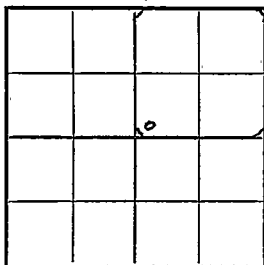

Hall-Gurney Pool

Location \_\_\_\_\_

Rig up \_\_\_\_\_

Drilling and Remarks:

Cable rig and tools

RECORD

Cased \_\_\_\_\_ in., \_\_\_\_\_ ft.

Sand \_\_\_\_\_

Gas \_\_\_\_\_

Oil \_\_\_\_\_

Total Depth \_\_\_\_\_

PRODUCTION

1st 24 hrs. Nat. \_\_\_\_\_

1st 24 hrs. after shot \_\_\_\_\_

Gas \_\_\_\_\_ Cu. Ft.

Dry Hole \_\_\_\_\_

Abandoned \_\_\_\_\_

Date

OCT 13 1943 19

S. J. LEWIS Scout

Russell

KANSAS 2  
 Map No. 72 Sec. 28 Twp. 14 R. 14W

Well No. 3 Olson "B"

Sterns, Vernon O&G et al. Company

ABANDONED Contractor

SW NE

SECTION PLAT

		o	

\_\_\_\_\_ Ft. from N. Line

330 Ft. from S. Line

\_\_\_\_\_ Ft. from E. Line

330 Ft. from W. Line

Hall-Gurney Pool

Location \_\_\_\_\_

Rig up \_\_\_\_\_

Drilling and Remarks:

*See 3278*

RECORD

Cased \_\_\_\_\_ in., \_\_\_\_\_ ft.

Sand \_\_\_\_\_

Gas \_\_\_\_\_

Oil \_\_\_\_\_

Total Depth 3280

PRODUCTION ~

1st 24 hrs. Nat. \_\_\_\_\_

1st 24 hrs. after shot \_\_\_\_\_

Gas \_\_\_\_\_ Cu. Ft.

Dry Hole \_\_\_\_\_

Abandoned \_\_\_\_\_

Date

DEC 15 1943 19

S. J. LEWIS Scout