

# KANSAS


Russell

FORM 51 5M 10-41 PETROL

Section 28 Township 14 Range 14-W

Well No. 1 Flegler

Company Westgate Greenland

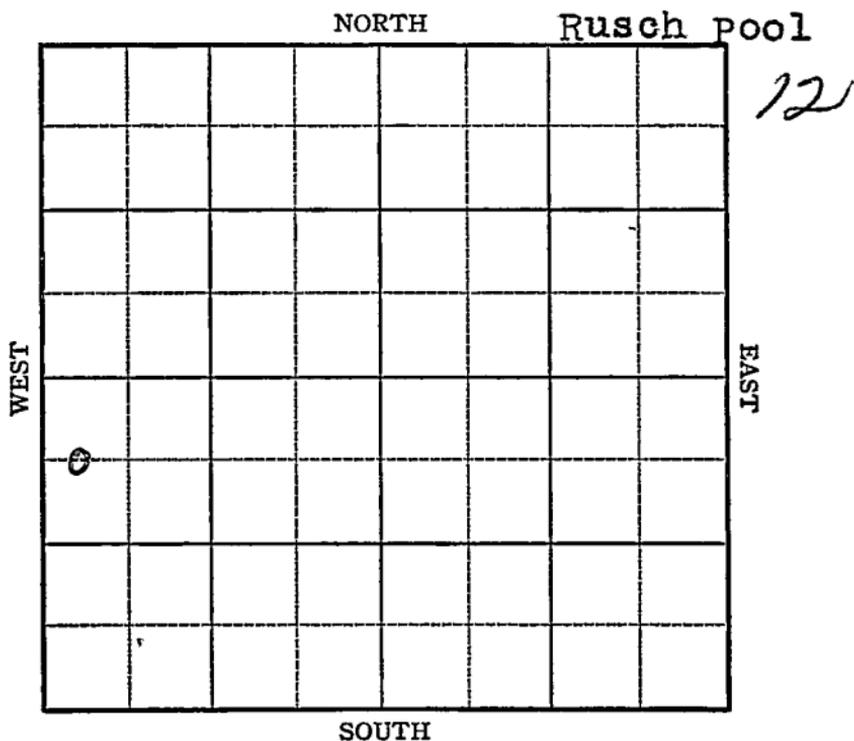



Rus se 11

**KANSAS**

Map No. 72 Sec. 28 Twp. 14 R. 14W

Well No. 1 Flegler

Westgate Greenland Company

**FIRST REPORT** Contractor

C W  $\frac{1}{2}$  NW SW

660 Ft. from N. Line

\_\_\_\_\_ Ft. from S. Line

\_\_\_\_\_ Ft. from E. Line

330 Ft. from W. Line

**SECTION PLAT**

0			

**RUSCH POOL**

Location \_\_\_\_\_

Rig up \_\_\_\_\_

Drilling and Remarks:

10" - 150'

Lans. 2951'

7" - 3049'

Small show oil

3145'-49'

Good show oil

3163'-67'

Arb. 3212'  $\bar{T}.D.$

**RECORD**

Cased \_\_\_\_\_ in., \_\_\_\_\_ ft.

Sand \_\_\_\_\_

Gas \_\_\_\_\_

Oil \_\_\_\_\_

Total Depth \_\_\_\_\_

**PRODUCTION**

1st 24 hrs. Nat. \_\_\_\_\_

1st 24 hrs. after shot \_\_\_\_\_

Gas \_\_\_\_\_ Cu. Ft.

Dry Hole \_\_\_\_\_

Abandoned \_\_\_\_\_

Date

DEC 3 1941 19 \_\_\_\_\_

S. J. LEWIS Scout

Map No. 92 Sec. 28 Twp. 14 R. 14WWell No. 1 FleglerWestgate-Greenland CompanyABANDONED ContractorC  $W\frac{1}{2}$  NW SW660 Ft. from N. Line

\_\_\_\_\_ Ft. from S. Line

\_\_\_\_\_ Ft. from E. Line

330 Ft. from W. Line

## SECTION PLAT

o			

## RUESCH POOL

Location \_\_\_\_\_

Rig up \_\_\_\_\_

Drilling and Remarks:

*Oct 9 212**5 " 3213**Water*

## RECORD

Cased \_\_\_\_\_ in., \_\_\_\_\_ ft.

Sand \_\_\_\_\_

Gas \_\_\_\_\_

Oil \_\_\_\_\_

Total Depth 3240

## PRODUCTION

1st 24 hrs. Nat. \_\_\_\_\_

1st 24 hrs. after shot \_\_\_\_\_

Gas \_\_\_\_\_ Cu. Ft.

Dry Hole \_\_\_\_\_

Abandoned \_\_\_\_\_

Date

DEC 17 1941 19S. J. LEWIS

Scout