


Section 28 Township 14 Range 14-W

Well No. #4 Flegler

Company Duke & Wood

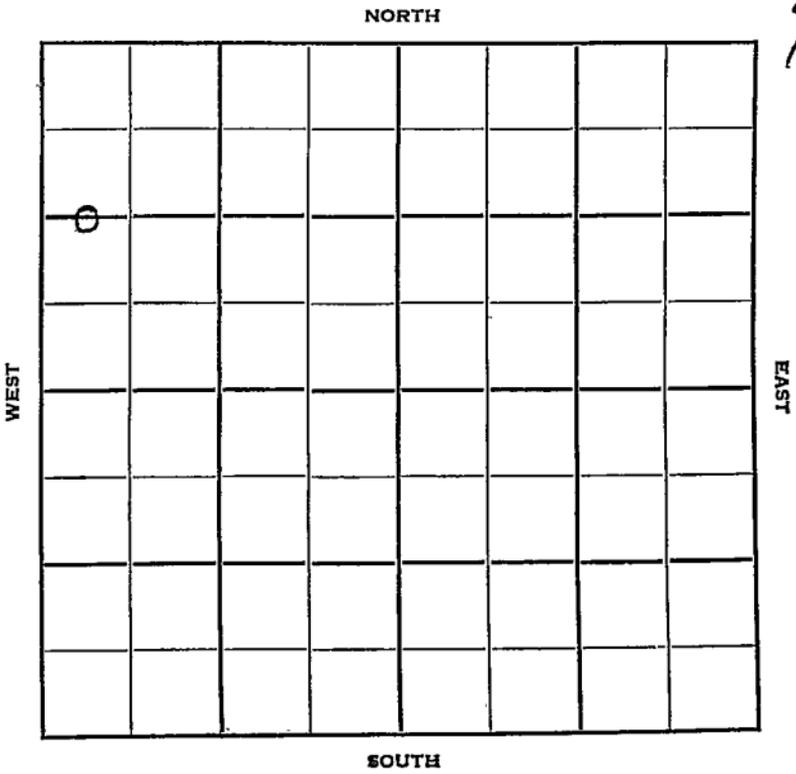

28

14

14W

Sec. _____ Twp. _____ R. _____

#4 Flegler

Well No. _____ Farm _____

Duke & Wood

Company

Contractor

Big Creek Pool

1320'

Ft. from N. Line


Ft. from S. Line

Ft. from E. Line

330'

Ft. from W. Line

C $W\frac{1}{2}$ $W\frac{1}{2}$ NW

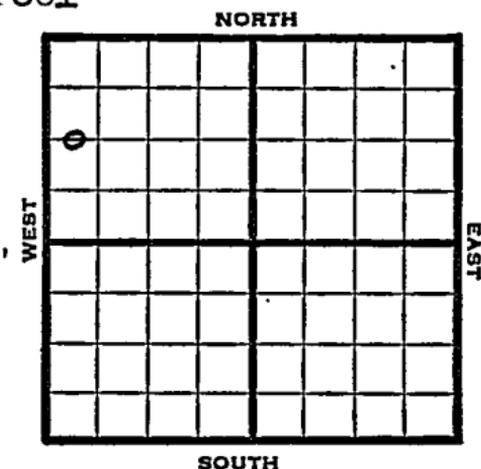

1950

Elev. 1817'

REPORT

8/16

Spud 8-7-50

8-5/8" @ 237'

Anhy 793-837'

Drlg. 2496'

9/20

8 5/8" @ 237

Anhy 793-837

Top 2675

Lans 2963

DST 3006-10 opn 17 min rec 60' ocm

good show of gas

DST 3057-68 opn 18 min rec 50' ocm

Arb 3220-23

5" @ 3220

Perf 3059-63

P/160 to 170 bopd

Comp 100 bopd

Completed

COMPLETED

County Russell State Kansas

Sec. 28 (Blk. Twp.) 14 (Sur. Rge.) 14W Map No.

Operator Duke & Wood

Well No. 4 Farm Flegler

Elev. 1817 Location C W $\frac{1}{2}$ W $\frac{1}{2}$ NW

1320 Ft. From N Line NW

330 Ft. From W Line Quarter

1st. Report AUG 16 1950

Completion _____

Remarks _____

Spudding Date 8-7-50

Drlg. Data Big Creek Pool

8 5/8" @ 237 Anhy 793-837 drlg. 2496

J. E. TYRA

County Russell State Kansas

Sec. 28 (Blk. 14) (Sur. 14W) (Twp. Map No.)

Operator Duke & Wood

Well No. 4 Farm Flegler

Elev. 1817 Location C W $\frac{1}{2}$ W $\frac{1}{2}$ NW

1320 Ft. From N Line NW

330 Ft. From W Line Quarter

Ist. Report ~~SEP 20 1950~~

Completion SEP 20 1950

Remarks

Big Creek Pool

Spudding Date 8-7-50

Drlg. Data Oil well TD 3223

8 5/8" @ 237 Anhy 793-837 Top. 2675

Lans. 2963 DST 3006-10 open 17 min.

Rec. 60' ocm good show of gas DST 3057-

68 open 18 min. Rec. 50' ocm

Arb. 3220-23 5" @ 3220 Perf. 3059-63

P/ 160 to 170 bopd Comp. 100 bopd

J. E. TYRA