


Section 28 Township 14 Range 13W

Well No. #6 Graham

Company Cities Service

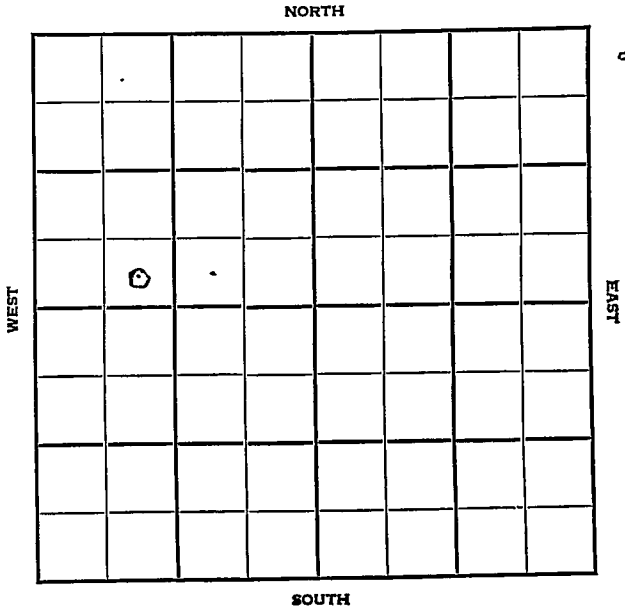

Sec. 28 Twp. 14 R. 13W

Well No. #6 Graham Farm

Cities Service Company

Hall-Gurney


         Ft. from N. Line

330 Ft. from S. Line

         Ft. from E. Line

990 Ft. from W. Line

SE SW NW

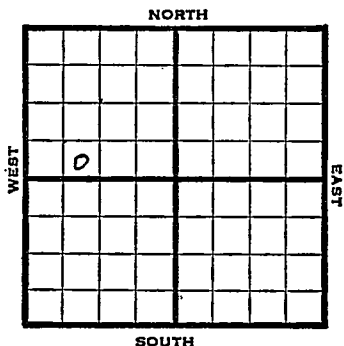

1948

Elev 1747' REPORT

1/21  
1/26

Location  
RUR

2/4

8" @ 280'  
Drlg. 2425'

2/11

Gorham 3154-65' TD  
5" @ 3155'  
RUST

2/18

"

2/25

Tarkio 2261'  
Topeka 2556'  
Lansing 2870'  
62 shots 2965-89  
23 " 2914-20  
44 " 2890-2904  
20 " 2873-78

3/3

Lans. 2870'  
Gorham 3154'  
5" @ 3155'  
Perf Lans.  
5000 Acid  
Pump 254 Oil / 24 W Pot  
Gr. 40°  
Total Depth 3165'

**COMPLETED**

Map No. \_\_\_\_\_ Sec. 28 Twp. 14 R. 13W

Well No. 6 Graham

Cities Service Company

FIRST REPORT

Contractor

SE SW NW


SECTION PLAT

\_\_\_\_\_ Ft. from N. Line

330 Ft. from S. Line

\_\_\_\_\_ Ft. from E. Line

990 Ft. from W. Line

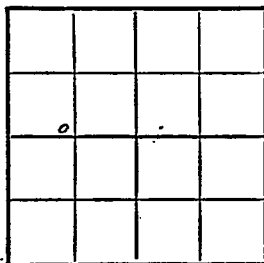

Russell County

Location X

Rig up

Drilling and Remarks:

RECORD

Cased \_\_\_\_\_ in., \_\_\_\_\_ ft.

Sand \_\_\_\_\_

Gas \_\_\_\_\_

Oil \_\_\_\_\_

Total Depth \_\_\_\_\_

PRODUCTION

1st 24 hrs. Nat. \_\_\_\_\_

1st 24 hrs. after shot \_\_\_\_\_

Gas \_\_\_\_\_ Cu. Ft.

Dry Hole \_\_\_\_\_

Abandoned \_\_\_\_\_

Date

JAN 21 1948

19

S. J. LEWIS Scout

Map No. 72 Sec. 28 Twp. 14 R. 13W

Well No. 6 Graham

Cities Service Company

**COMPLETE** Contractor

SE SW NW

*E11742*

**SECTION PLAT**

\_\_\_\_\_ Ft. from N. Line

330 Ft. from S. Line

\_\_\_\_\_ Ft. from E. Line

990 Ft. from W. Line


Russell County

Location \_\_\_\_\_

Rig up \_\_\_\_\_

Drilling and Remarks:

*Liams 2870*

*Boe ham 3157*

*3" @ 3155*

*Prof Liams  
5000 acial*

*Pump 254 oil + 24W*

*Ret 40 I G*

**RECORD**

Cased \_\_\_\_\_ in., \_\_\_\_\_ ft.

Sand \_\_\_\_\_

Gas \_\_\_\_\_

Oil

Total Depth 3165

**PRODUCTION**

1st 24 hrs. Nat. \_\_\_\_\_

1st 24 hrs. after shot \_\_\_\_\_

Gas \_\_\_\_\_ Cu. Ft.

Dry Hole \_\_\_\_\_

Abandoned \_\_\_\_\_

Date

MAR 3 1948 19

S. J. LEWIS Scout