


Section 28 Township 14 Range 14-W

Well No. 1 Olson "B"

Company Stearns & Vernon

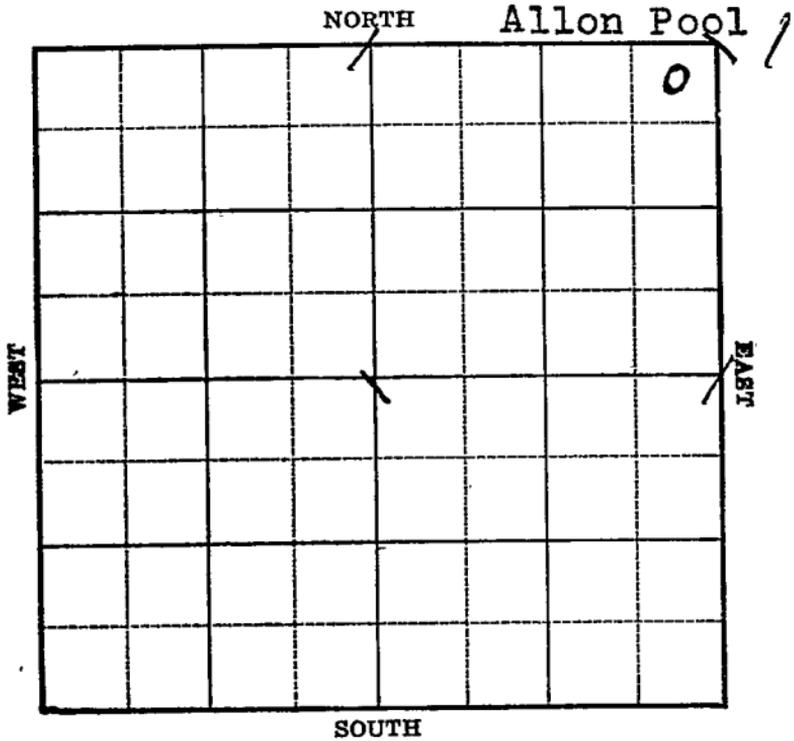

Sec. 28 Twp. 14 R. 14-WWell No. #1 Olson "B" FarmStearns & Vernon Company

(Allon)


330 Ft. from N. Line

_____ Ft. from S. Line

330 Ft. from E. Line

_____ Ft. from W. Line

Elev. 1825

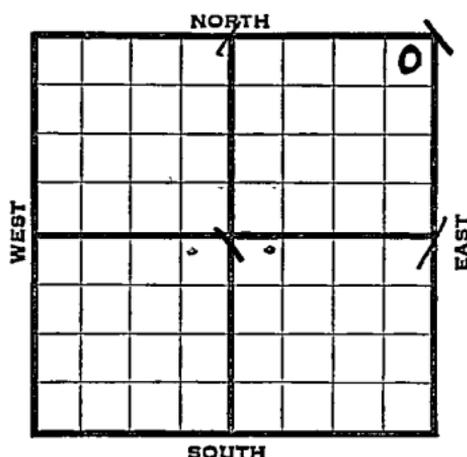

1939	REPORT
3/1	B.C.R.
3/10	R. U.
3/17	20" - 160' 15" - 324' Drlg. 346'
3/24	13" - 480' Anhy 807' Rng. 10".
3/31	10" - 809' Drlg. 1837'
4/7	8" - 2415' Drlg. 2425'
4/14	8" - 2420' Topeka 2685' S. O. 2685-88' 1/2 B.W. 2890' S. O. 2894-2902' Dodge 2931' Lans. 2976-79' T.D. S.S.O. Rng. 7".
4/21	7" - 2978' Drilled plug. S.S.O. 2995-3000 & 3011-14. S. O. & G. 3066-75' Swab 30 oil & 1 1/2 water in 24 hrs 200' oil in 2 hrs. at 3100-05' Drlg. 3107'
	OVER

1939

4/28

5" - 3202' Gorham sd. 3215'

Pay 3218-20' T.D. 3224'

1000' oil in 5 hours.

Swab 34 oil & 5 water in 7 hrs.

S.D.O.

5/5

P. B. to 3079' 10000 acid.

Potential 1961 bbls.

5/10

Gorham sand 3215'

7" - 2978'

5" liner 3202'

T.D. 3224'

P. B. to 3079'

1000 acid.

Potential 1961 bbls.

COMPLETED

Russell

Map No. _____ Sec. 28 Twp. 14 R. 14WWell No. 1 Olson "B"Stearns & Vernon Company

Contractor

FIRST REPORT

NE/C

330 Ft. from N. Line

_____ Ft. from S. Line

330 Ft. from E. Line

_____ Ft. from W. Line

ALLON POOL

SECTION PLAT

Location _____

Rig up _____

Drilling and Remarks:

BCR

RECORD

Cased _____ in., _____ ft.

Sand _____

Gas _____

Oil _____

Total Depth _____

PRODUCTION

1st 24 hrs. Nat. _____

1st 24 hrs. after shot _____

Gas _____ Cu. Ft.

Dry Hole _____

Abandoned _____

Date

MAR 1 - 1939 19

H. D. Hatfield

Scout

Misc Small Maps	<i>Ray</i>
Cards	<i>Ray</i>
Tracing	<i>Ray</i>
Topo Map	<i>Ray</i>
Enough Map	<i>Ray</i>
Map	
col Dept.	
Flat Book	

Russell

KANSAS

Map No. _____ Sec. 28 Twp. 14 R. 14WWell No. 1 Olson "B"Stearns & Vernon Company

Contractor

COMPLETE

NE/C

SECTION PLAT

330 Ft. from N. Line

			o

_____ Ft. from S. Line

330 Ft. from E. Line

_____ Ft. from W. Line

ALLON POOL

Location _____

RECORD

Cased _____ in., _____ ft.

Sand _____

Gas _____

Oil _____

Total Depth 3224

Rig up _____

Drilling and Remarks:

*Gorkham Sol.**3215.**7" @ 2978**5" bit @ 3202.**P.B 3079**10000 acid**Pat. F961*

PRODUCTION

1st 24 hrs. Nat. _____

1st 24 hrs. after shot _____

Gas _____ Cu. Ft.

Dry Hole _____

Abandoned _____

Date

MAY 10 1939 19

S. J. LEWIS Scout

Misc Small Maps *RAM*
Cards *RAM*
Tracing *RAM*
France Map *RAM*
Scarborough Map *RAM*
Moody Map
Geological Dept.
Moody Flat Book