

KANSAS

Russell


Section 29 Township 14 Range 15W

Well No. #1 Aley

Company Coralena

NORTH

7

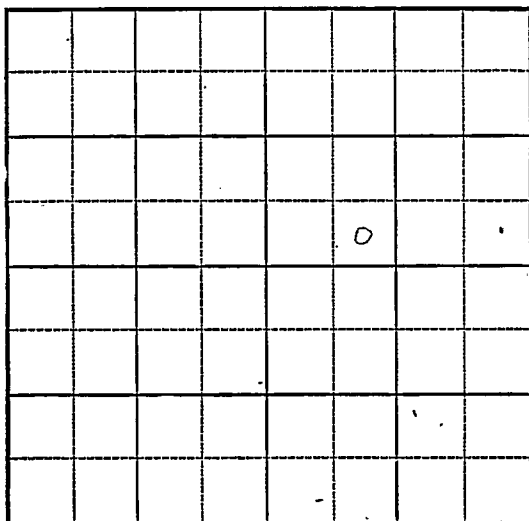

					0		

WEST

EAST

SOUTH

C


Sec. 29 Twp. 14 R. 15W

Well No. 1 Aley Farm

Coralena Company

SE SW NE

NORTH

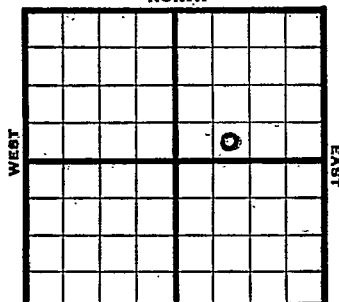

 Ft. from N. Line

330 Ft. from S. Line

 Ft. from E. Line

990 Ft. from W. Line

Elev. 1810

1944

REPORT

9-13 Cellar

9/21 10" @ 506

Anhy 872

Drlg. 2151

9/28 Topeka 2734

TD 3328

Run 7"

10/4 Lans 3017

Arb 3282

7" @ 3280

TD 3294 RUST

10/11 " " "

10/18 PB 3194

10/25 1600 acid

Pump 1 oil in 3 hrs 1600 acid

1600' acid Estimate 1 oil per hr

1600 acid swb 14 oil in 12 hrs.

" " " " " " "

P B 3084 24 shots 3034 - 3045

1600 accid

Pump 30 water a day PB

" " " " " "

" " " " " "

" " " " " "

" " " " " "

" " " " " "

" " " " " "

" " " " " "

" " " " " "

" " " " " "

" " " " " "

" " " " " "

OVER

1945

1/17 400' oil plus 800' wtr in 6 days

1/26 PB 3006

18 shots 2942-2948 SO

1/31 Arb. 3282

7" @ 3180

TD 3294'

ABANDONED

Pool Name Big Creek

KANSAS


Map No. 72 Sec. 29 Twp. 14 R. 15WWell No. 1 AleyCoralena

Company

FIRST REPORT
SE SW NE

Contractor

SECTION PLAT

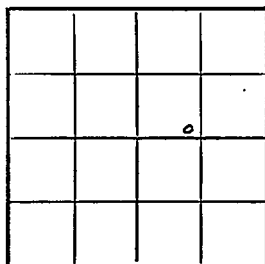 Ft. from N. Line330 Ft. from S. Line Ft. from E. Line990 Ft. from W. LineRussell CountyLocation Rig up

Drilling and Remarks:

Cellar

RECORD

Cased in., ft.Sand Gas Oil Total Depth

PRODUCTION

1st 24 hrs. Nat. 1st 24 hrs. after shot Gas Cu. Ft.Dry Hole Abandoned

Date

SEP 13 1944

19

S. J. LEWIS

Scout

Pool Name Big Creek PoolMap No. 77 Sec. 29 Twp. 14 R. 15WWell No. 1 AleyCoralena CompanyABANDONED ContractorSE SW^{NE}E

SECTION PLAT

 Ft. from N. Line330 Ft. from S. Line Ft. from E. Line990 Ft. from W. Line

Russell

Location Rig up

Drilling and Remarks:

Ar 83282
2" @ 8180

RECORD

Cased in., ft.Sand Gas Oil Total Depth 3294

PRODUCTION

1st 24 hrs. Nat. 1st 24 hrs. after shot Gas Cu. Ft.Dry Hole Abandoned

Date

JAN 31 1945 19

S. J. LEWIS Scout