


Section 29 Township 14 Range 15WWell No. #1 FosterCompany Victor Drlg.

NORTH

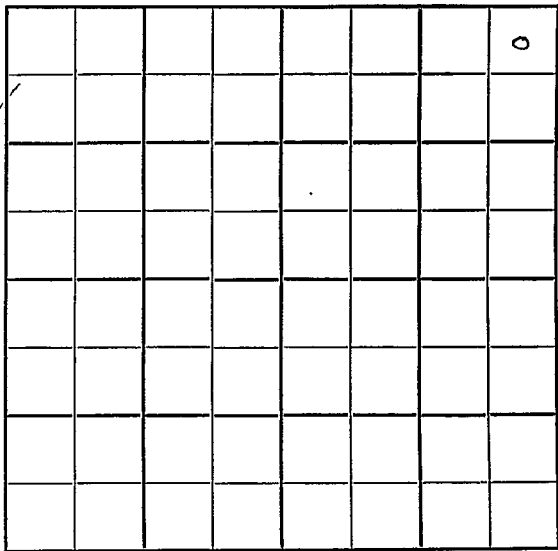

							o

SOUTH

Russell

KANSAS

Sec. 29 Twp. 14 R. 15W

Well No. #1 Foster Farm

Victor Drlg.

Company

Contractor

330

Wildcat

Ft. from N. Line

Ft. from S. Line


330

Ft. from E. Line

Ft. from W. Line

NE NE NE

Northern Pump DHM

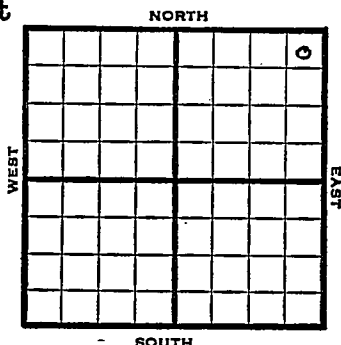

1952

Elev. 1782'

REPORT

3/5 Location

3/12 "

3/19 8" @ 860
Anhy 860-85
Drlg. 1785'

4/2 Spud 3-13-52
D&A TD 3340
8" @ 860
Top 2750
Tor. 2996
Cong. 3263
TD 3340
D&A

Anhy 860-85
Heeb. 2975
Lans. 3025
Arb. 3309

ABANDONED

County Russell State KansasSec. 29 (Blk. 14 (Sur. 15W Map No. 15W)
(Twp.) (Rge.)Operator Victor Drlg.Well No. 1 Farm FosterElev. _____ Location NE NE NE

330 Ft. From N Line NE330 Ft. From E Line Quarter1st. Report MAR 5 1952

Completion _____

Remarks Northern Pump-DM


Spudding Date _____

Drlg. Data Wildcat

Location _____

J. G. McGEHEE

County Russell State Kansas
 Sec. 29 (Blk. Twp.) 14 (Sur. Rge.) 15W Map No. _____
 Operator Victor Drlg.
 Well No. 1 Farm Foster
 Elev. 1782 Location NE NE NE

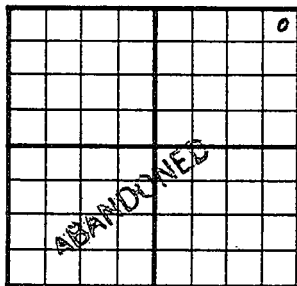

330 Ft. From N Line NE
330 Ft. From E Line Quarter
 Ist. Report _____
 Completion APR 2 1952
 Remarks Wildcat

Spudding Date 3-13-52

Drlg. Data D & A TD 3340

8" @ 860 Anhy 860-85 Top. 2750

Heeb. 2975 Tor. 2996 Lans. 3025

Cong. 3263 Arb. 3309 TD 3340

D & A

J. G. McGEHEE