


Map No. KANSAS Sec 29 Twp. 14 R. 15<sup>w</sup>  
Well No. 5 Gorham #1 Farm \_\_\_\_\_ Company \_\_\_\_\_  
Murphy #1

*Russell*

NORTH

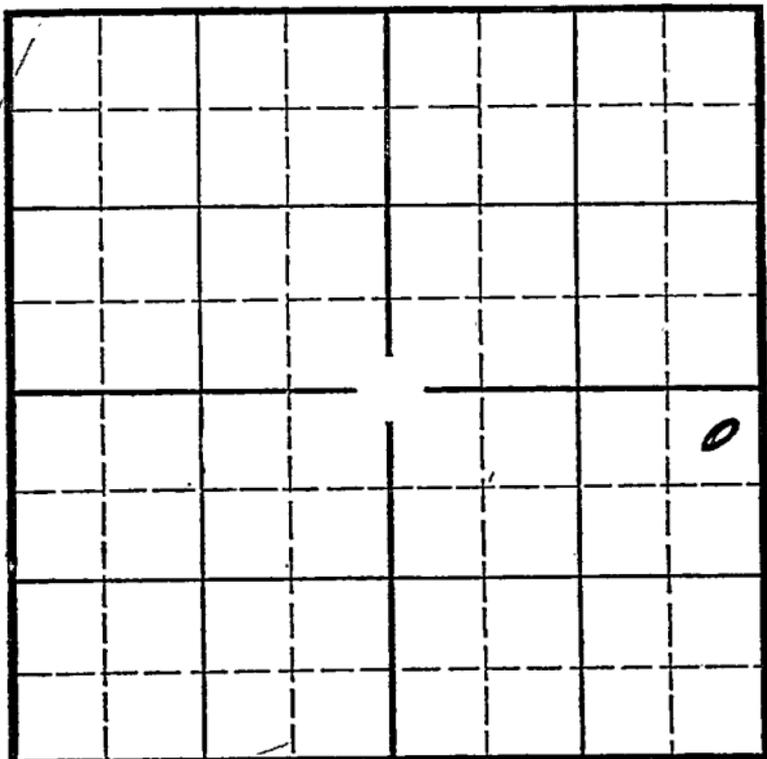

Location \_\_\_\_\_  
Drilling Remarks \_\_\_\_\_  
\_\_\_\_\_  
\_\_\_\_\_  
Rig Up \_\_\_\_\_  
Drilling Remarks \_\_\_\_\_  
\_\_\_\_\_  
\_\_\_\_\_  
RECORD

Cased \_\_\_\_\_ in. \_\_\_\_\_ ft.  
Sand \_\_\_\_\_  
Gas \_\_\_\_\_  
Oil \_\_\_\_\_  
Total Depth \_\_\_\_\_

PRODUCTION

1st 24 hrs. Nat. \_\_\_\_\_  
1st 24 hrs. after shot \_\_\_\_\_  
Gas \_\_\_\_\_ cu. ft. \_\_\_\_\_  
Dry Hole \_\_\_\_\_  
Abandoned \_\_\_\_\_

Russell

Map No. KANSAS Sec. 29 Twp. 14 R. 15<sup>W</sup>

Well No. 1 - Gorham Est Farm  
Murfin et al Company


330 Ft. from N. Line

\_\_\_\_\_ Ft. from S. Line

330 Ft. from E. Line

\_\_\_\_\_ Ft. from W. Line

Elev. 1801

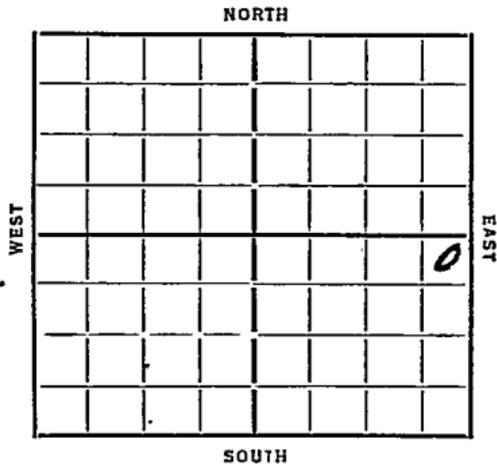

Date 1935 REPORT

5/15 Cellar  
5/23 — 5/29 — 6/6 — 6/13 — 6/20 —  
6/28 — 7/3 — 7/14 — 7/18 — 8/8 —  
8/15 — 8/22 — 8/29 — 9/6 — 10/3 —  
10/19 Machine  
11/1 15" 367 TD 615 to run 12"  
11/7 Alg 1580 10" 875  
11/24 " 2210  
11/21 8" 2401 TD 2500 WR 8"  
11/29 Alg 2730 8" 2507  
12/6 " 2750 8" 2593  
12/13 6" 3030 C.O.  
12/19 6" 3020 Top Sewell 3020  
do 3091-95  
Increased 3105-3115  
12/23 Alg 3282  
TD 3313

D & A.

**ABANDONED**

Map No. 72 Sec. 29 Twp. 14 R. 15W

Well No. 1-Boham est  
Murphy et al Company

Contractor

**FIRST REPORTS**

330 Ft. from N. Line

..... Ft. from S. Line

330 Ft. from E. Line

..... Ft. from W. Line

**SECTION PLAT**

			o

Location.....

Rig up.....

Drilling and Remarks:

*Ceclaw*

**RECORD**

Cased..... in., ..... ft.

Sand.....

Gas.....

Oil.....

Total Depth.....

**PRODUCTION**

1st 24 hrs. Nat.....

1st 24 hrs. after shot.....

Gas..... Cu. Ft.

Dry Hole.....

Abandoned.....

**ORVAL MANNSCHRECK**

Date

5-15-35 192

Scout

Map No. 72 Sec. 29 Twp. 14 R. 15W

Well No. 1 - Boham est

Musfin et al Company

Contractor

**ABANDONED**

**SECTION PLAT**

330 Ft. from N. Line

..... Ft. from S. Line

330 Ft. from E. Line

..... Ft. from W. Line

			0

Location.....

Rig up.....

Drilling and Remarks:

*U + A*

**RECORD**

Cased..... in., ..... ft.

Sand sil 3282

Gas.....

Oil.....

Total Depth 3313

**PRODUCTION**

1st 24 hrs. Nat.....

1st 24 hrs. after shot.....

Gas..... Cu. Ft.

Dry Hole.....

Abandoned.....

Date

12-23-35 192.....

**ORVAL MANNSCHRECK**

Scout