


KANSAS Russell

FORM 51 IOM 12-46 PETROL

Section 29 Township 14 Range 14W

Well No. 1 Billings "A"

Company C. G. Kissinger

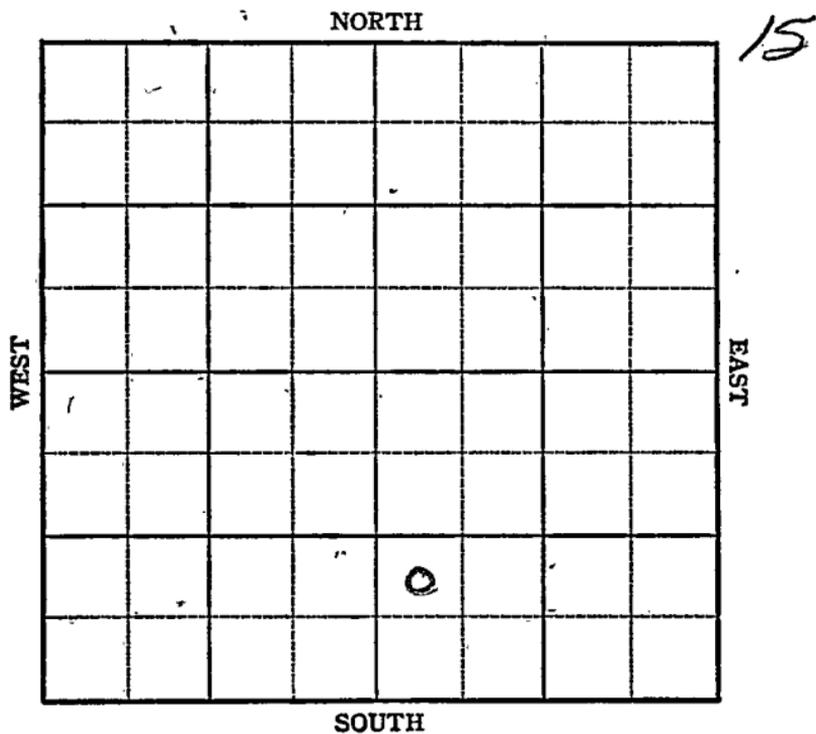

Sec. 29 Twp. 14 R. 14-W

Well No. #1 Billings "A" Farm

C. G. Kissinger Company


Hall-Gurney Pool

 Ft. from N. Line

990 Ft. from S. Line

 Ft. from E. Line

330 Ft. from W. Line

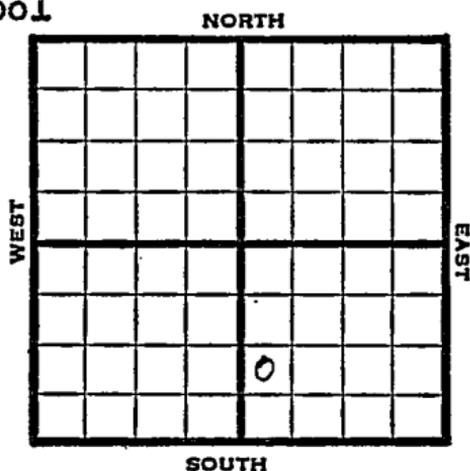

NW SW SE

1947 Elev. 1776' REPORT

5/21 10" @ 791'
Anhy 785
Drlg 1650'

5/27 1855' Crooked hole
PB
Drlg. 915'

6/3 Drlg 1630'

6/10 Lost Hole
Drlg. 2210'

6/12 Drlg 2645'

6/24 Topeka 2640-2900'
Fsg.

7/1 Drlg 2640'

7/8 Fishing 2770'

7-16 Drlg. 2942

7/22 Drlg -3116'

7/30 Lans. 2969'
Arb. 3220'
TD 3222'

ABANDONED

Map No. 72 Sec. 29 Twp. 14 R. 14W

Well No. 1 Billings "A"

C. G. Kissinger Company

FIRST REPORT Contractor

NW SW SE


SECTION PLAT

_____ Ft. from N. Line

990 Ft. from S. Line

_____ Ft. from E. Line

330 Ft. from W. Line

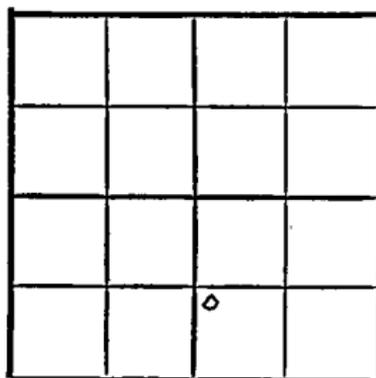

Russell County

Location _____

Rig up _____

Drilling and Remarks:

10" @ 791
Anhy 785
drlg. 1650

RECORD

Cased _____ in., _____ ft.

Sand _____

Gas _____

Oil _____

Total Depth _____

PRODUCTION

1st 24 hrs. Nat. _____

1st 24 hrs. after shot _____

Gas _____ Cu. Ft.

Dry Hole _____

Abandoned _____

Date

MAY 21 1947 19

S. J. LEWIS Scout

KansasMap No. _____ Sec. 29 Twp. 14 R. 14WWell No. 1 Billings "A"C. G. Kessinger Company**ABANDONED**

Contractor

NW SW SE

E11776
SECTION PLAT

_____ Ft. from N. Line

990 Ft. from S. Line

_____ Ft. from E. Line

330 Ft. from W. Line

		σ	

Russell County

Location _____

Rig up _____

Drilling and Remarks:

Lease 2969Per 8220**RECORD**

Cased _____ in., _____ ft.

Sand _____

Gas _____

Oil _____

Total Depth 3222**PRODUCTION**

1st 24 hrs. Nat. _____

1st 24 hrs. after shot _____

Gas _____ Cu. Ft.

Dry Hole _____

Abandoned _____

Date

JUL 30 1947

19

S. J. LEWIS

Scout