

KANSAS


Form 51-5M-7-39-Palace

Russell

Section 29 Township 14 Range 14-W

Well No. #1 Marie Becker

Company Haynes
~~Hays~~ & Anschutz

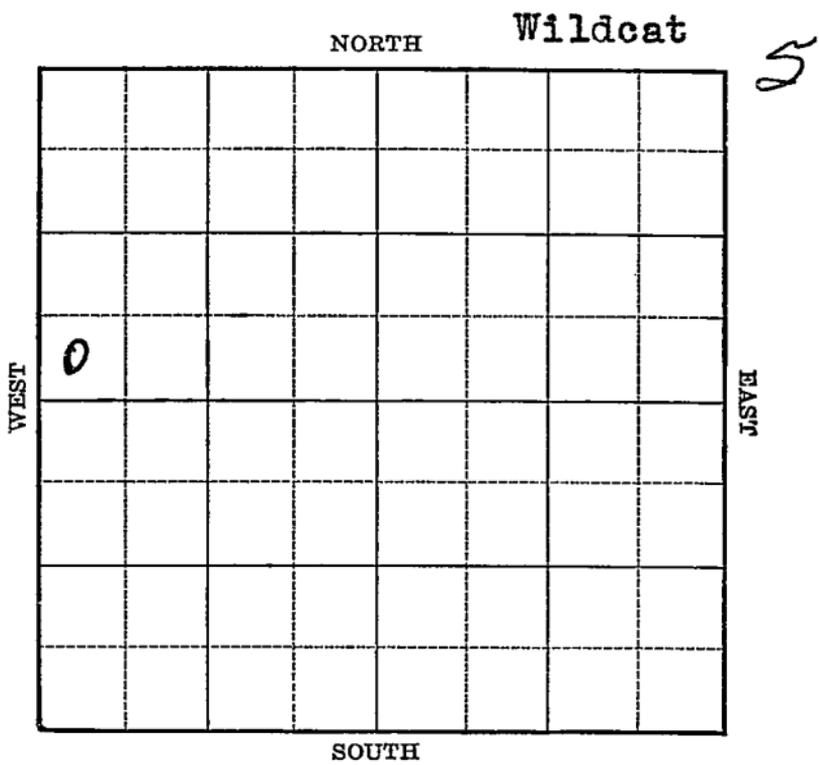

Sec. 29 Twp. 14 R. 14-W

Well No. #1 Marie Becker Farm
Haynes
Hays & Anschutz Company

(Wildcat)


 Ft. from N. Line

330 Ft. from S. Line

 Ft. from E. Line

330 Ft. from W. Line

Elev. 1808

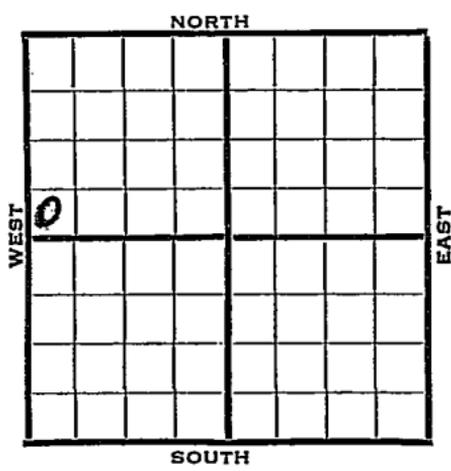

1940	REPORT
3/20	Cable rig.
	Rigging up.
3/28	15" - 254' 12" - 465'
	Anhy 819' 10" - 825'
	Drlg. 835'
4/4	10" - 835' Drlg. 1960'
4/12	8" - 2425' Drlg. 2575'
4/18	Topeka 2700' Dodge 2954'
	Lans. 2989' 7" - 3002'
	Drlg. 3100'
4/24	Arb. 3248'
	Sand 3251'
	T.D. 3252'
	Water.
	ABANDONED

Map No. 72 Sec. 29 Twp. 14 R. 14WWell No. 1 Marie BeckerHays & Anschutz

Company

Contractor

FIRST REPORT

SW NW


_____ Ft. from N. Line

330 Ft. from S. Line

_____ Ft. from E. Line

330 Ft. from W. Line

SECTION PLAT

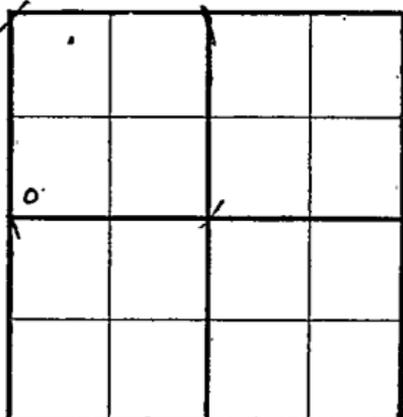

WILDCAT

Location _____

Rig up _____

Drilling and Remarks:

Cable rig
rigging up

RECORD

Cased _____ in., _____ ft.

Sand _____

Gas _____

Oil _____

Total Depth _____

PRODUCTION

1st 24 hrs. Nat. _____

1st 24 hrs. after shot _____

Gas _____ Cu. Ft.

Dry Hole _____

Abandoned _____

Date

MAR 20 1940

19

S. J. LEWIS

Scout

Russell **KANSAS**Map No. 72 Sec. 29 Twp. 14 R. 14WWell No. 1 Marie BeckerHaynes & Anschutz CompanyCORRECTION Contractor**SECTION PLAT**

SW NW

_____ Ft. from N. Line

330 Ft. from S. Line

_____ Ft. from E. Line

330 Ft. from W. Line**WILDCAT**

Location _____

Rig up _____

Drilling and Remarks:

Reported as**Hays & Anschutz****RECORD**

Cased _____ in., _____ ft.

Sand _____

Gas _____

Oil _____

Total Depth _____

PRODUCTION

1st 24 hrs. Nat. _____

1st 24 hrs. after shot _____

Gas _____ Cu. Ft.

Dry Hole _____

Abandoned _____

Date

MAR 27 1940 19S. J. LEWIS Scout

Map No. 72 Sec. 29 Twp. 14 R. 14W

Well No. 1 Marie Becker

Haynes & Anschutz Company

Contractor

ABANDONED

SW NW

_____ Ft. from N. Line

330 Ft. from S. Line

_____ Ft. from E. Line

330 Ft. from W. Line

WILDCAT

SECTION PLAT

Location _____

Rig up _____

Drilling and Remarks: [^]

Oil 3248

Sand 3251

Water

RECORD

Cased _____ in., _____ ft.

Sand _____

Gas _____

Oil _____

Total Depth 3252

PRODUCTION

1st 24 hrs. Nat. _____

1st 24 hrs. after shot _____

Gas _____ Cu. Ft.

Dry Hole _____

Abandoned _____

Date

APR 24 1940 19

S. J. LEWIS Scout