

KANSAS


FORM 51 5M 1-42 PETROL

Russell

Section 29 Township 14 Range 14-W

Well No. #1 Rasch "A"

Company Gulf

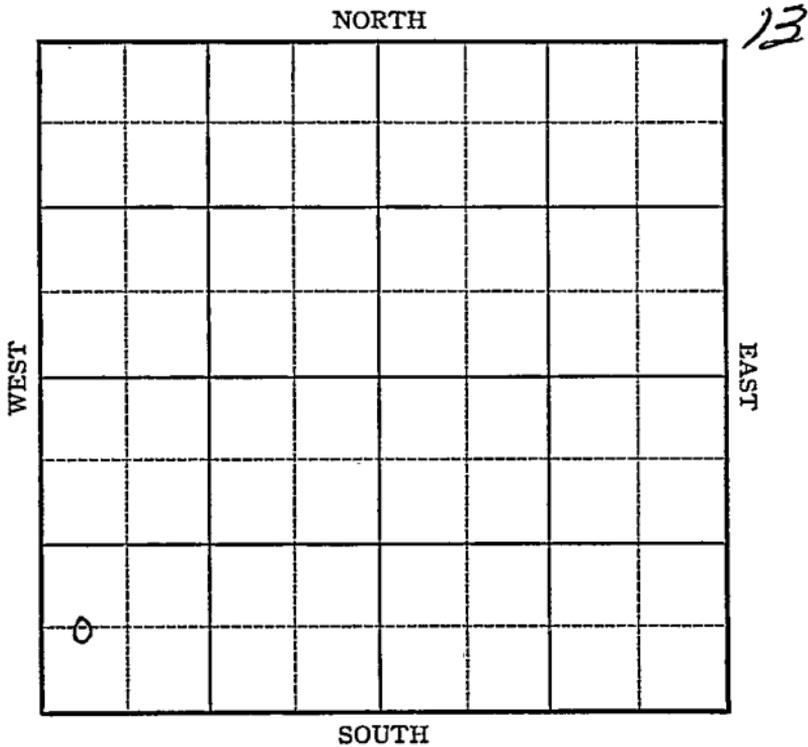

Sec. 29- Twp. 14 R. 14-W

Well No. #1 Rusch "A" Farm _____


Gulf Company

_____ Ft. from N. Line

660 Ft. from S. Line

_____ Ft. from E. Line

330 Ft. from W. Line

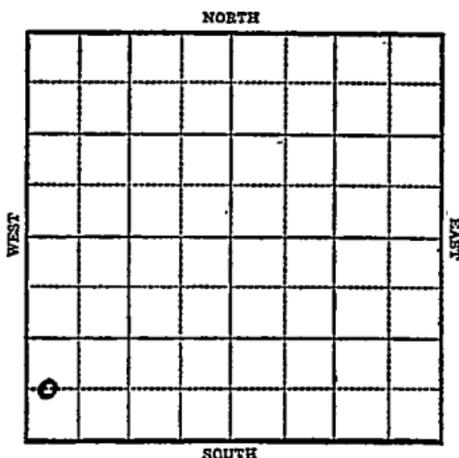

1943

R E P O R T

5/19

7" - 423'

T.D. 550'

S.W.D.

FIRST REPORT

ABANDONED

Rus se ll

KANSAS

Map No. 72 Sec. 29 Twp. 14 R. 14W

Well No. 1 Rusch 'A'

Gulf Company

FIRST REPORT Contractor

~~ABANDONED~~
~~COMPLETED~~
~~ABANDONED~~

C WL SW SW SECTION PLAT

 Ft. from N. Line

660 Ft. from S. Line

 Ft. from E. Line

330 Ft. from W. Line

RUSCH POOL

Location

Rig up

Drilling and Remarks:

S.W.D.

7" - 423'

T.D. 550'

Complete for

*Ball & Water
Superior
well.*

RECORD

Cased in., ft.

Sand

Gas

Oil

Total Depth 330

PRODUCTION

1st 24 hrs. Nat.

1st 24 hrs. after shot

Gas Cu. Ft.

Dry Hole

Abandoned Abandoned

Date

MAY 19 1943 19


S. J. LEWIS Scout

5/25/43

Shouldn't this be #1-A

We have a #1 on this 40 acres and there cannot be two #1 on the same 40 acres.

Oma

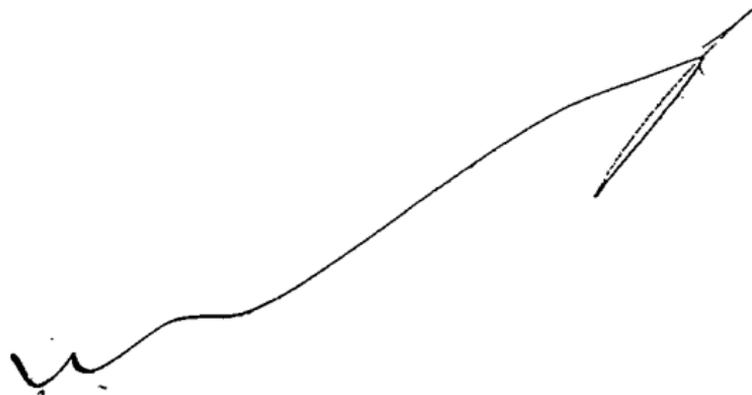

Misc. Small Maps	<i>Oma</i>
Cards	<i>Beats</i>
Tracing	<i>MB</i>
France Map	<i>MB</i>
Scarborough Map	<i>MB</i>
Moody Map	<i>MB</i>
Geological Dept.	
Moody Flat Book	