


Section 29 Township 14 Range 11W

Well No. 2 Rush "B"

Company Duke & Wood

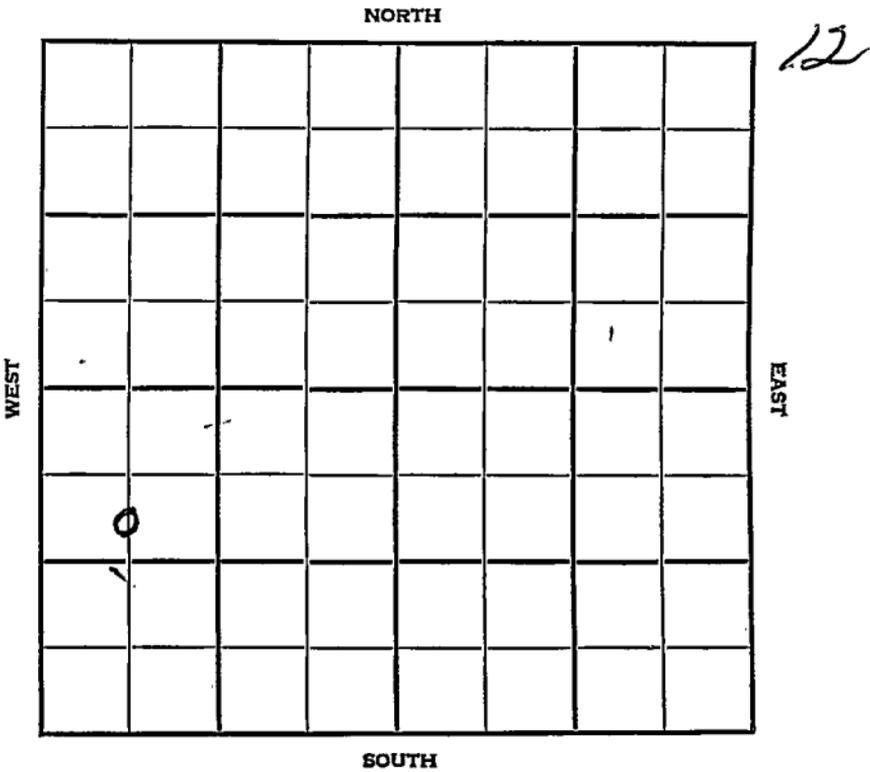

Russell

KANSAS

SEC.	TWP.	R.
29	14	14 W

WELL NO. # 2 Rush "B" FARM

COMPANY Duke & Wood

CONTRACTOR Co. tools


990 Ft. from N. Line

Ft. from S. Line

Ft. from E. Line

660 Ft. from W. Line

C S $\frac{1}{2}$ NW SW

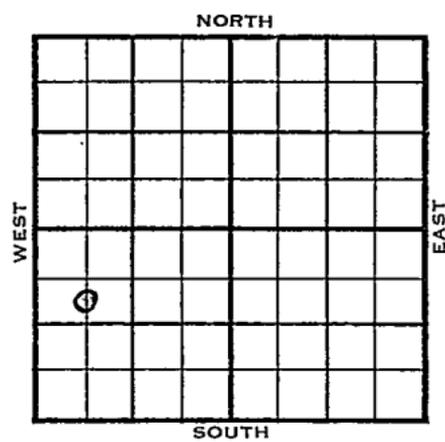

	ELEVATION	REPORT
1954	1782'	

10/20 Spud 10-14-54
8-5/8" @ 253
Drlg. 1823'

11/10 Spud 10-14-54 - Oil Well
TD 3219'
8-5/8" @ 253'
Heeb 2913', Lans 2976', Arb. 3216'
DST 3208-19', opnl hr., rec. 235'
froggy oil, 940#
TD 3219'
5" @ 3216'
CO to 3219'
FU 400' fluid 12 hrs., 250A
Comp. 35 BOPD 80% wtr.

COMPLETED

