


KANSAS Kansas Pool Name Salina
 Map No. 5 Sec. 17 Twp. 14 R. 3W

Well No. 1 Beil
D. W. Geary Company

FIRST REPORT Contractor

SW SE SE

SECTION PLAT

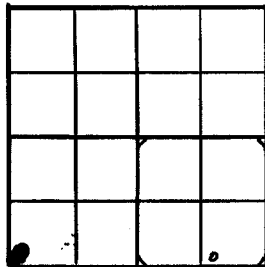

 Ft. from N. Line
330 Ft. from S. Line
990 Ft. from E. Line
 Ft. from W. Line

Saline County

Location Rig up Drilling and Remarks: SH	RECORD	
	Cased	in, ft.
	Sand	
	Gas	
	Oil	
	Total Depth	
	PRODUCTION	
	1st 24 hrs. Nat.	
	1st 24 hrs. after shot	
	Gas	Cu. Ft.
	Dry Hole	
	Abandoned	

Date JUN 5 1946 19 S. J. LEWIS Scout

KANSAS Kansas Pool Name Salina Pool
 Map No. 5 Sec. 17 Twp. 14 R. 3W


Well No. 1 Beil
D. W. Geary Company

ABANDONED

SW SE SE

Contractor

SECTION PLAT

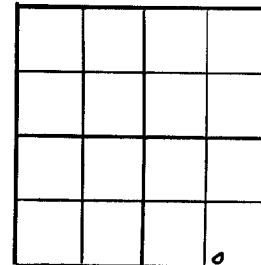

 Ft. from N. Line
330 Ft. from S. Line
990 Ft. from E. Line
 Ft. from W. Line

Saline County

Location Rig up Drilling and Remarks: <i>Lane 3250</i> <i>Mis 2915</i> <i>Hunt 3375</i> <i>Vista 3520</i> <i>Sm 3660</i> <i>Cur 3749</i>	RECORD	
	Cased	in, ft.
	Sand	
	Gas	
	Oil	
	Total Depth	<i>3763</i>
	PRODUCTION	
	1st 24 hrs. Nat.	
	1st 24 hrs. after shot	
	Gas	Cu. Ft.
	Dry Hole	
	Abandoned	

Date JUN 26 1946 19 S. J. LEWIS Scout

KANSAS

Saline County

Sec. 17 Twp. 14 R. 3W

Well No. #1 Beil Farm _____

D. W. Geary Company _____


Salina

_____ Ft. from N. Line

330 _____ Ft. from S. Line

290 _____ Ft. from E. Line

_____ Ft. from W. Line

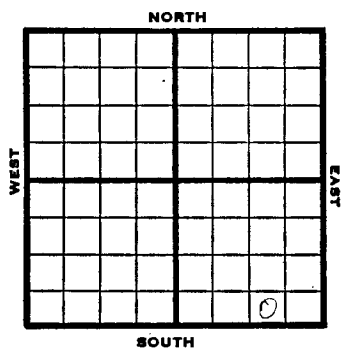

SW SE SE

1946 Elev. 1257 REPORT

6/5 SH
6/12 12" @ 167
8" @ 310'
Drlg 320'
6/18 Miss 2920
Drlg 3064'
6/26 Lans 3250
Miss 2918
Hunton 3375
Viola 3560
Simp. 3663
Arb. 3749
TD 3763'

ABANDONED

KANSAS

Saline

Section 17 Township 14 Range 3W

Well No. 1 Beil

Company D. W. Geary

