


Cove

KANSAS

SECTION 3 TOWNSHIP 14S RANGE 28W

WELL NO. #1 Evans "A"

COMPANY Pickrell Drlg.

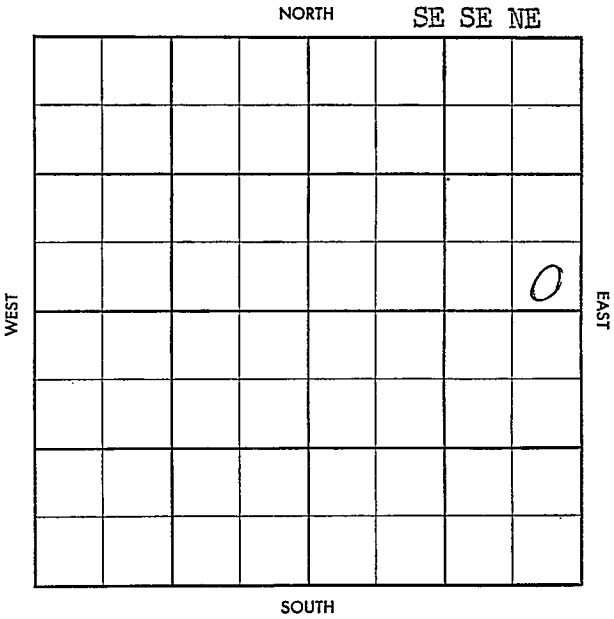

# WILDCAT

S-513-A

FIRST REPORT

CO. Cove ELEV. \_\_\_\_\_

SEC. 3 TWP. 14 RGE. 28W

COMPANY Pickrell Drlg. NO. 1

DEC	4	57	o

FARM Evans "A" Pan-American - DHC

LOC. SE SE NE

Top	3360
feeb	3728
Top	3748
Lans	3768

GEOL. \_\_\_\_\_

CONTR. Co. Tools

POOL Wildcat

SPUD 11/26/57

8" @ 197 w/160 Drlg.

4020 Miss Test.

LSE. NO. SEC. TWP. RGE.


5-513-A

CO. ~~Gove~~ ELEV 2583 ~~TR~~  
SEC. ~~B~~ TWP. 14 RGE. 28W  
COMPANY Piekrell Drlg. NO. 1 ABANDONED

DEC 11 '57

FARM Evans "A" Pan-American - DHC  
LOC. S. SE 1 E

Top. 2300  
Leob 3728  
Top 3748  
Lans 3768

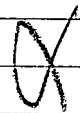GEOL.   
CONTR. Co. Tools  
POOL Wildcat  
SPUD 11/26/57  
8" = 197 w/160 Drls.

4020 Miss Test.  
MISS 4354  
RT 17 4505  
near top tops  
A 2035 463731

TR 3752 Lsg 3770 BKC 4064  
M&M 4110 Ce 4266 Miss 4354

DBA

CO.  
LSE.  
NO.  
SEC.  
TWP.  
RGE.